

**LAND CORNER RECORDATION CERTIFICATE**  
**Filing Requirement of Act 74, Mich. P.A. 1970**

MARQUETTE COUNTY  
 MICHIGAN  
 RECEIVED FOR RECORD

1999 FEB 12 PM 3:34

*Patsie M. Nealey*  
 REGISTER OF DEEDS

LIBER **R2** PAGE **162**  
 Register of Deeds Stamp & File Number

for corners in SECTION

<u>MARQUETTE</u> (County)	Located In: Ishpeming Township	Corner Code #
1. Public Land Survey	T48N R27W T49N R27W T____ R____ T____ R____	J-01 J-13 ✓ _____ _____
2. Property Controlling in Section	S____ T____ R____ S____ T____ R____	_____ _____
3. Miscellaneous Property in Sec.	S____ T____ R____ S____ T____ R____	_____ _____

4. Lot No. \_\_\_\_\_, Recorded Plat \_\_\_\_\_  
 5. Private Claims \_\_\_\_\_

I, George M. Platz, in a field survey on December 7, 1998 do hereby state that under requirements of P.A. 74, Michigan P.A. of 1970, the corner points mentioned in lines 1 and 2 above were in conformance with regulations and rules therefore as required in the current manual of survey instructions of the United States Department of the Interior, Bureau of Land Management or by a decree of a Court of Law and /or that the corner points mentioned in lines 3, 4 and 5 above were in conformance with the rules of the Michigan Board of Land Surveyors or by a Decree of a Court of Law; established, re-established, monumented, recovered, found as expressed below:

NOTE: Not more than 2 corners, all in the same town and range, may be recorded on this certificate.

1/4 corner common to: Section 2 T.48N., R.27W.  
 Section 35 T.49N., R.27W.

A	B	C	D	E	F	G	H	I	J	K	L	M
1												
2	6		5		4		3		2		1	
3												
4	7		8		9		10		11		12	
5												
6	18		17		16		15		14		13	
7												
8	19		20		21		22		23		24	
9												
10	30		29		28		27		26		25	
11												
12	31		32		33		34		35		36	
13												

WITNESSED BY PEER GROUP  
 P.A. 345 OF 1990

*James J. Burson*  
 DATE 12/15/98

A. Description of original monument and accessories and/or subsequent restoration:

1846: Original US Government Survey by Austin Burt - Set wood post witnessed by:  
 East 19 Links 14" Cedar  
 N07°W 39 Links 18" Cedar

1916 - 1918: Section corner coordinate information from Cleveland Cliffs Iron Company indicates the corner to be a "standard" brass capped monument. No additional information given.

1981: L.C.R.C. recorded in L.4 of R.C., P.145, Marquette County Records. Robert Schmeling PS 8317 - Found 1 1/2" diameter iron pipe with "standard" brass cap. Stamped "MEAD" "RLS 8317", "1981" on cap. Witnessed by:  
 N18°E 40.5'; nail in E of White Cedar  
 S32°W 21.4'; nail in E of White Cedar  
 N30°W 22.2'; nail in E of White Cedar


B. Description of corner evidence found and/or method applied in restoring or reestablishing corner:

Found 1-1/2" iron pipe with "standard" brass cap, 12"+/- above ground as described in 1981 L.C.R.C. recorded in L.4 of R.C., P.145, Marquette County Records. Point is located in a heavy cedar swamp surrounded by old growth cedar. A thorough search found no evidence of any other survey monumentation or occupation in the immediate area. No evidence of original B.T.'s could be found. An original GLO line call to the EAST, being "Ascend Cliff", compares 528'(R), 606'(M). The position of this corner has been used and accepted by others as evidenced by line markings. All measurements, obtainable recorded survey information and any other obtained unrecorded survey information made available to Spalding DeDecker Associates is documented in the research dossier. Considering the above information, all known evidence favors the correctness of this point.

C. Description of monument for corner and accessories established to perpetuate locating the position of the corner:

Accepted found 1 1/2" diameter galvanized iron pipe with "standard" brass cap. Stamped "MCR 1998" on brass cap to properly identify accepted corner. Made the following new witnesses:

Az. 18° 40.5' Found PK nail in S face of 15" Cedar  
 Az. 177° 16.43' Set mag nail w/tag No.38121 in N face of 5" Cedar  
 Az. 213° 21.4' Found PK nail in N face of 23" Cedar. Affixed new SDA B.T. tag  
 Az. 332° 22.15' Found PK nail in E face of 12" Cedar

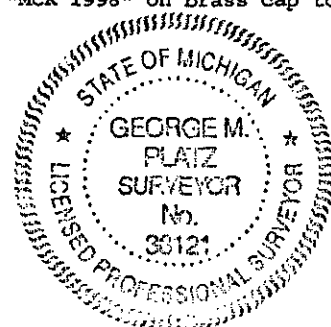

Signed by George M. Platz

Date 12-30-98

Surveyor's Michigan License No. 38121