

MAR 10 1999

LAND CORNER RECORDATION CERTIFICATE
Filing Requirement of Act 74, Mich. P.A. 1970

MARQUETTE COUNTY MICHIGAN RECEIVED FOR RECORD

1999 FEB 12 PM 3:34

For corners in SECTION

Table with columns: MARQUETTE (County), Located In: Ishpeming Township, Corner Code #. Rows include Public Land Survey (T48N R27W, T49N R27W, K-01, K-13), Property Controlling in Section, and Miscellaneous Property in Sec.

Historian R. M. M... REGISTER OF DEEDS

LIBER R2 PAGE 164 Register of Deeds Stamp & File Number

4. Lot No. ... Recorded Plat ...
5. Private Claims ...

Grid table with columns A-M and rows 1-13. A dot is marked in cell K1.

I, George M. Platz, in a field survey on December 7, 1998 do hereby state that under requirements of P.A. 74, Michigan P.A. of 1970, the corner points mentioned in lines 1 and 2 above were in conformance with regulations and rules therefore as required in the current manual of survey instructions of the United States Department of the Interior, Bureau of Land Management or by a decree of a Court of Law and for that the corner points mentioned in lines 3, 4 and 5 above were in conformance with the rules of the Michigan Board of Land Surveyors or by a Decree of a Court of Law; established, re-established, monumented, recovered, found as expressed below:

NOTE: Not more than 2 corners, all in the same town and range, may be recorded on this certificate.

Section corner common to: Section 1 T.48N., R.27W. Section 2 T.48N., R.27W. Section 35 T.49N., R.27W. Section 36 T.49N., R.27W.

A. Description of original monument and accessories and/or subsequent restoration:

1846: Original US Government Survey by Austin Burt - Set wood post witnessed by: East 19 links; 14" Cedar N7°W 39 links; 18" Cedar

1916 - 1918: Section corner coordinate information from Cleveland Cliffs Iron Company indicates the corner to be a "standard" brass capped monument. No additional information given.

1981: L.C.R.C. recorded in L.4 of R.C., P.146, Marquette County Records. Robert Schmeling, PS 8317 - Found 1 1/2" diameter iron pipe with "standard" brass cap. Stamped "MEAD" "RLS 8317", "1981" on cap. Witnessed by: N60°E 27.5'; nail in E of 6" White Cedar S54°E 16.2'; nail in E of 10" White Cedar S55°W 24.0'; nail in E of 11" Black Spruce N72°W 31.2'; nail in E of 11" White Cedar

B. Description of corner evidence found and/or method applied in restoring or reestablishing corner:

Found 1-1/2" iron pipe with "standard" brass cap, 36"+/- above ground as described in 1981 L.C.R.C. recorded in L.4 of R.C., P.146, Marquette County Records. A thorough search found no evidence of any other survey monumentation or occupation in the immediate area. The position of this corner has been used and accepted by others as evidenced by line markings. No evidence of original B.T.'s could be found. Distinct original GLO line calls to the west of this point have been forever changed by the flooding of the Dead River Basin. All measurements, obtainable recorded survey information and any other obtained unrecorded survey information made available to Spalding DeDecker Associates is documented in the research dossier. Considering the above information, all known evidence favors the correctness of this point.


C. Description of monument for corner and accessories established to perpetuate locating the position of the corner:

Accepted found 1 1/2" diameter galvanized iron pipe with "standard" brass cap. Stamped "MCR 1998, PLATZ 38121" on brass cap to properly identify accepted corner. Made the following new witnesses:

- Az. 56° 27.62' Set mag nail w/tag No.38121 in NE face of 8" Cedar
Az. 134° 16.34' Set mag nail w/tag No.38121 in SW face of 14" Cedar with B.T. tag affixed
Az. 232° 24.15' Set mag nail w/tag No.38121 in SE face of 14" Spruce
Az. 280° 31.18' Set mag nail w/tag No.38121 in S face of 15" Cedar

RATIFIED BY PEER GROUP P.A. 345 OF 1990

Signature of Larry J. Bussone DATE 12/14/98

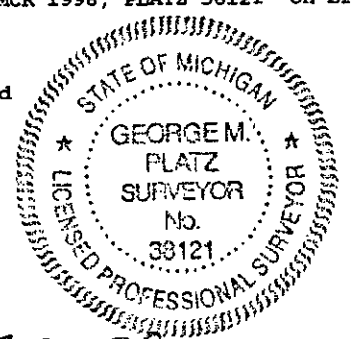

Signed by George M. Platz

Date 12-30-98

Surveyor's Michigan License No. 38121