

LAND CORNER RECORDATION CERTIFICATE


Authority: 1970 PA 74, MCL 54.205

Surveyor's Name: Stephan J. Szyszkoski

Field Survey Date: See below

For corner(s) in: Marquette County

Original Public Land Survey Corner		Corner Code
a. S _____	T 49N R 28W	J5 (GCDB 540500)
b. S _____	T 49N R 28W	H5 (GCDB 440500)
S _____	T _____ R _____	_____
S _____	T _____ R _____	_____
Property Corner		1/16 Corner Code
S _____	T _____ R _____	_____
S _____	T _____ R _____	_____
S _____	T _____ R _____	_____
S _____	T _____ R _____	_____

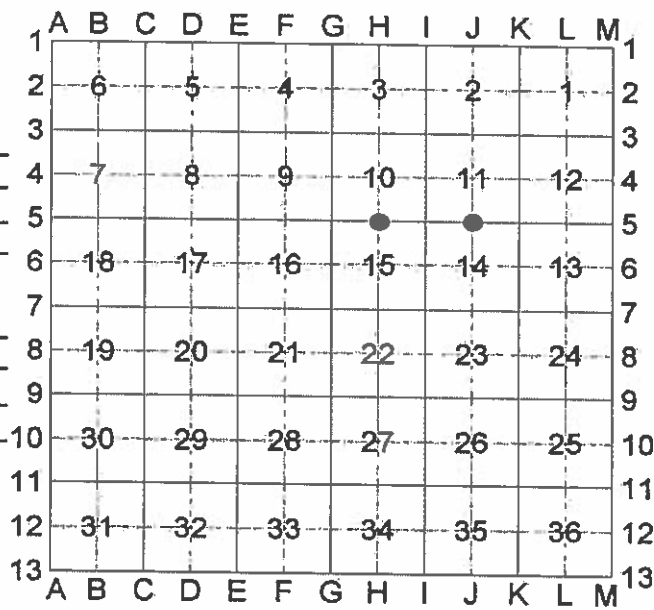

Part A. Corner History

- a.) Quarter corner common to Sections 11 and 14. 1852 - Established by A.B.Wood, Deputy, midway and on the Section line between Section corners 40.02 chains East and West. Set post. Hemlock 12" S75°E 11 links, B.Ash 10" N10°W 30 links. 1946 - Marquette County Road Commission notes: Old BT Hemlock 12" S75°E 11 links still standing and growing and in very good condition. Black Ash BT gone. Iron pipe and spruce post on west edge of small ledge. Set new BT B.Ash 14" N79°W 9.2'
- b.) Quarter corner common to Sections 10 and 15. 1852 - Established by A.B.Wood, Deputy, midway and on the Section line between Section corners 40.15 chains east and west. Set post. Fir 8" S35°E 7 links, Spruce 7" North 42 links. Found no subsequent record.

Part B: Surveyor's Report on Perpetuation, Restoration, Reestablishment, or Monumentation of Corner

- a.) July 24, 2017. Found a 3/4"x15" long iron pipe, very corroded, at record bearing and distance from the original Hemlock BT 12" (now 45" DBH) S75°E 11 links. The Hemlock is still alive and in very good condition. Also at record bearing and distance was found the 1946 NBT B.Ash, now 18" DBH, also in good condition with overgrown blazes. Accepted the position of the pipe as a careful and faithful perpetuation of the position of the original corner and replaced it with a new monument as described below.
- b.) July 25, 2017. The original post and accessories were not recovered. Found no evidence of the position of the original corner on the ground. Reestablished the position for the corner midway and on the Section line between Section corners 2652.20' east and west.

Part C: Field Evidence of Perpetuation or Monumentation of Corner

- | | |
|--|---|
| <p>a.) Set 1"IDx28" I.pipe with 2" alum. MDNR cap. Set measuring nail with MDNR tag in the side of:
 45" Hemlock S72°E 8.1' old blazes (an original BT)
 18" B.Ash N76°W 9.3' old blazes (the 1946 NBT)
 6" Y.Birch S28°W 9.3' mrkd "1/4S NBT"
 5" Sugar N20°E 21.9' do
 Set sq'd cedar post adjacent.
 E= 7940962.193 N= 207853.433</p> | <p>b.) Set 1"IDx28" I.pipe with 2" alum. MDNR cap. Set measuring nail with MDNR tag in the side of:
 9" Maple N11°E 14.35' mrkd "1/4S NBT"
 10" Balsam S86°E 12.7' do
 6" Maple S26°E 23.65' do
 7" Maple S86°W 30.1' do
 Set sq'd cedar post adjacent.
 E= 7939348.526 N= 207885.151</p> |
|--|---|

Bearings are magnetic. Coordinates are MCS83 in meters, NAD83(2011) Epoch 2010.00 datum.
 Coord. Ref.=NGS PID RK0336: N= 205572.794 m. E= 7940583.999 m.

Stephan J. Szyszkoski 08/02/2017

