

1

LAND CORNER RECORDATION CERTIFICATE
Filing Requirement of Act 74, Mich. P.A. 1970

For corners in


Table with columns: Marquette (County), Located In, Corner Code //
1. Public Land Survey T 50N R 27W I-3, I-4
2. Property Controlling in Section S 11 T 50N R 27W 3
3. Miscellaneous Property in Sec. S T R

Register of Deeds Stamp & File Number

- 4. Lot No. Recorded Plat
5. Private Claims

I, Paul R. Bressette, in a field survey on September 19 1994, do hereby certify that under requirements of P.A. 74, Michigan P.A. of 1970, the corner points mentioned in lines 1 and 2 above were in conformance with regulations and rules therefor as required in the current manual of survey instructions of the United States Department of the Interior, Bureau of Land Management or by a decree of a Court of Law and/or that the corner points mentioned in lines 3, 4 and 5 above were in conformance with the rules of the Michigan Board of Land Surveyors or by a Decree of a Court of Law, established, re-established, monumented, re-monumented, recovered, found as expressed below:

NOTE: Not more than 4 corners, all in the same town and range, may be recorded on this certificate.

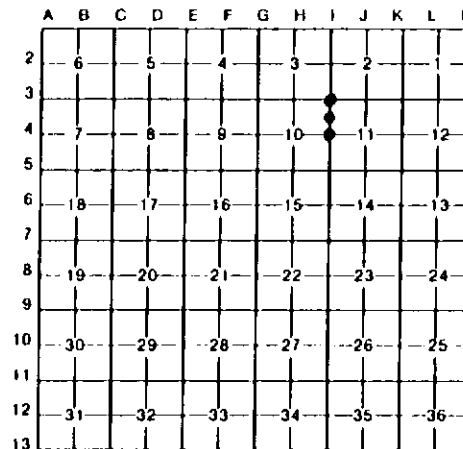

A. Description of original monument and accessories and/or subsequent restoration:

- I-3. Section Corner common to Sections 2,3,10 and 11. 1940's: Marquette Co. Rd. Comm. records indicate corner is a RR spike in the centerline of county road.
I-4. Quarter Corner common to Sections 10 and 11. 1913: Charles Cummings, Co. Surveyor. Drawing and description of county road references west line of Section 11. Road follows section line and north sixteenth line of Section 11. 1928: Marquette Co. Rd. Comm. Resurvey of road in Section 11. Notes indicate found iron pin at north sixteenth corner on west section line and a found RR spike at the section corner to north.
3. North One-sixteenth Corner common to Sections 10 and 11. 1913: Charles Cummings, Co. Surveyor. Drawing and description of county road shows PI at north sixteenth corner on west line of S.11. 1928: Marquette Co. Rd. Comm. Resurvey of county road in Section 11 notes show found (over)

B. Description of corner evidence found and/or method applied in restoring or reestablishing corner:


- I-3. Found RR spike in north-south road about 3 feet west of centerline. Distance south to found pipe measures 1319.52 feet (MCRC records-1321.4 feet). Accepted found RR spike as corner and witnessed.
I-4. Cummings drawing shows distance from NW corner of S.11 to W 1/4 corner of S.11 as 2655 feet. Calculation of curve at sixteenth corner gives distance of 1327.5 feet from PI to NW corner. MCRC records give distance from NW corner to PI as 1321.5 feet. Found RR spike and iron pipe as noted in MCRC records measures 1319.52 feet. Excavation at a point on line from the found RR spike through the found iron pipe and 1319.52 feet from the pipe revealed an old post hole. An old fence runs along this line and turns to the west at this point. Corner position was re-established on the line from the found RR spike through the found iron pipe and at equal distance making the iron pipe mid-point and on-line. Measurement south to foot of hill call checks very well.

- 3. Found 1" iron pipe in line with road to north and old road to east. Hole in rust inside of pipe fits a found iron pin. Accepted iron pipe as corner and replaced it with a DNR monument.

C. Description of monument for corner and accessories established to perpetuate locating the position of the corner:

Table with 3 columns: I-3. RR spike, I-4. DNR monument, 3. DNR monument
4" Hemlock N72E 35.0', 5" R.Maple N29E 31.2', 6" R.Maple N22E 16.75'
6" Sugar S52E 39.25', 8" R.Maple S79E 29.6', 6" Sugar S22E 13.4'
14" Hemlock S72W 76.2', 9" Sugar S57W 11.35', 6" R.Maple S58W 15.6'
\*P.Pole N18W 79.0', 8" Sugar N60W 19.25', 6" Sugar N26W 42.6'

\*nail w/DNR reference tag

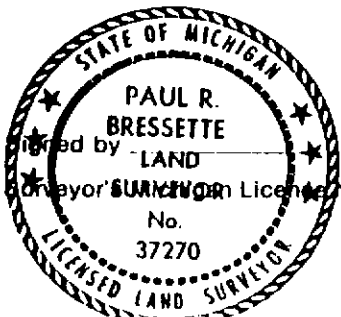

Paul R. Bressette Date

37270