

JUL 03 2000

MARQUETTE COUNTY MICHIGAN RECEIVED FOR RECORD

1996 NOV 22 AM 11:06

SECTION

LAND CORNER RECORDATION CERTIFICATE Filing Requirement of Act 74, Mich. P.A. 1970

For corners in Marquette (County)

Located In: Corner Code #

Table with 3 columns: Description, Located In, Corner Code #. Includes rows for Public Land Survey, Property Controlling in Section, and Miscellaneous Property in Sec.

Patricia A. Monley REGISTER OF DEEDS


LIBER R1 PAGE 312 Register of Deeds Stamp & File Number

4. Lot No. , Recorded Plat 5. Private Claims

Aug 29 1995

I, Stephan J. Szyszkoski, in a field survey on 19 do hereby state that under requirements of P.A. 74, Michigan P.A. of 1970, the corner points mentioned in lines 1 and 2 above were in conformance with regulations and rules therefore as required in the current manual of survey instructions of the United States Department of the Interior, Bureau of Land Management or by a decree of a Court of Law and/or that the corner points mentioned in lines 3, 4 and 5 above were in conformance with the rules of the Michigan Board of Land Surveyors or by a Decree of a Court of Law; established, re-established, monumented, recovered, found as expressed below:

NOTE: Not more than 2 corners, all in the same town and range, may be recorded on this certificate.

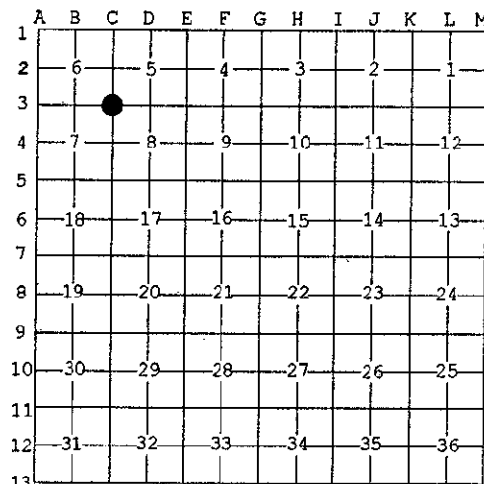

A. Description of original monument and accessories and/or subsequent restoration: (C3) Corner common to Sections 5-6-7-8. Corner established in 1852 by Abner B. Wood. From the original record: 1) Set post corner of Sections 5-6-7-8. 2) Hemlock 12 N15W 18, 3) Y. Birch 12 S75E 19, 4) South 9.9 chains Stream 4 C E, 5) North 3.00 Top of hill and descend 60 ft., 6) East 2.80 Stream 2 C SE. 7) North 40.00 1/4 Corner to Sections 5-6, 8) West 79.80 Corner to Sections 6-7. Found no subsequent record.

B. Description of corner evidence found and/or method applied in restoring or reestablishing corner: (C3) Remonumented the corner at the original position in accord with the best available evidence as referenced above: 1) Not found, 2) Found rotted hemlock stump of proper size at record bearing and distance, 3) Found stump hole with Y. Birch bark at record bearing and distance, 4) checks to stream 2 C. SE, 5) Checks, 6) Checks as described. 7) meas. 40.0631 to an original corner, 8) meas. 79.7580 to an original corner. At the position for the corner, I placed a 1"IDx32" iron pipe capped with a 4" dia. cast aluminum MDNR tablet, appropriately stamped.

RATIFIED BY PEER GROUP P.A. 345 OF 1990

Larry J. Bussard DATE 10/28/96

C. Description of monument for corner and accessories established to perpetuate locating the position of the corner:

(C3) Set 1" pipe with 4" MDNR cap. Blazed and scribed the following new bearing trees: MDNR monuments are 1"IDx32" iron pipe capped with a 4" dia. cast aluminum Michigan Department of Natural Resources tablet, stamped with Township, Range, corner ID, date of placement, and "PS 33986".

13" Hemlock N23W 19.6' (slope) "S6 NBT" 9" Hemlock N40E 27.6' "S5 NBT" 14" Maple N60E 14.6' "S5 NBT" 5" Ironwood S41W 12.0' "S7 NBT" Bearings are magnetic. Distances horizontal unless noted. New bearing trees are marked with a BH blaze and a lower blaze at the root crown. The blazes are scribed as indicated in quotation marks at left, with NBT or BT (as noted) being on the lower blaze. Distances are horizontal (unless noted) and measured from the corner to the inside of a notch cut into the bottom of the lower blaze.



Signed by Stephan J. Szyszkoski Surveyor's Michigan License No. 33986

Date 11-5-96

For the Michigan Department of Natural Resources - Forest Management Division