

MAY 22 1997

COMMISSION

MARQUETTE COUNTY MICHIGAN RECEIVED FOR RECORD

1996 NOV 22 AM 11:06

LAND CORNER RECORDATION CERTIFICATE Filing Requirement of Act 74, Mich. P.A. 1970

For corners in Marquette (County) Located in: Corner Code # 1. Public Land Survey T 50N R 29W L1

Patricia A. Monney REGISTER OF DEEDS

Register of Deeds Stamp & File Number 1 PAGE 314

4. Lot No. Recorded Plat 5. Private Claims

Jul 02 1996

I, Stephan J. Szyszkoski, in a field survey on 19 do hereby state that under requirements of P.A. 74, Michigan P.A. of 1970, the corner points mentioned in lines 1 and 2 above were in conformance with regulations and rules therefore as required in the current manual of survey instructions of the United States Department of the Interior, Bureau of Land Management or by a decree of a Court of Law and for that the corner points mentioned in lines 3, 4 and 5 above were in conformance with the rules of the Michigan Board of Land Surveyors or by a Decree of a Court of Law; established, re-established, monumented, recovered, found as expressed below:

NOTE: Not more than 2 corners, all in the same town and range, may be recorded on this certificate.


Grid table with columns A-M and rows 1-13. Cell (1, M) contains a circled '1'.

A. Description of original monument and accessories and/or subsequent restoration: (L1) North 1/4 corner of Section 1. Corner not established in the original survey. Found no subsequent record.

B. Description of corner evidence found and/or method applied in restoring or reestablishing corner: (L1) Found no evidence of prior monumentation at the corner position. Established the corner midway between closing corners 2623.02 feet east and west and on the 5th Correction Line between the Standard Corner common to Sections 32-33 T51N-R28W and the South 1/4 corner of Section 32 T51N-R28W. At the position for the corner, I placed a 1"IDx32" iron pipe capped with a 4" dia. cast aluminum MDNR tablet, appropriately stamped. The date stamped on the cap is "10/2/95". The Standard Corner 31-32 is Easterly, 62.85' from this monument.

RATIFIED BY PEER GROUP P.A. 345 OF 1990 Date 10/28/96

C. Description of monument for corner and accessories established to perpetuate locating the position of the corner: (L1) Set 1" pipe with 4" MDNR cap. Blazed and scribed the following bearing trees: 7" Sugar N04E 16.3' 1/4S BT, 9" Sugar S41E 9.9' 1/4S BT, 7" Sugar S28W 6.5' 1/4S BT, 9" Sugar N38W 48.7' 1/4S BT. Placed a 4" squared sugar post adjacent. Bearings are magnetic. MDNR monuments are 1"IDx32" iron pipe capped with a 4" dia. cast aluminum Michigan Department of Natural Resources tablet, stamped with Township, Range, corner ID, date of placement, and "PS 33986". New bearing trees are marked with a BH blaze and a lower blaze at the root crown. The blazes are scribed as indicated in quotation marks at left, with NBT or BT (as noted) being on the lower blaze. Distances are horizontal (unless noted) and measured from the corner to the inside of a notch cut into the bottom of the lower blaze.

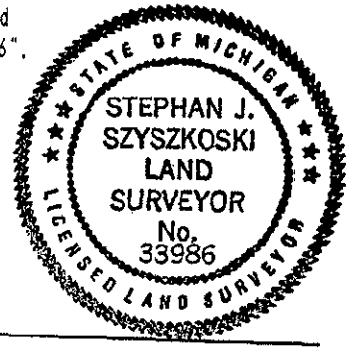

Signed by Stephan J. Szyszkoski Surveyor's Michigan License No. 33986

Date 11-5-96

For the Michigan Department of Natural Resources - Forest Management Division