


LAND CORNER RECORDATION CERTIFICATE
Filing Requirement of Act 74, Mich. P.A. 1970

For corners in
Marquette
 County

	Located In:	Corner Code #/4
1 Public Land Survey	T 50N R 29W	L4
	T R	
	T R	
	T R	
2 Property Controlling in Section	S 12 T R	5
	S T R	8
3 Miscellaneous Property in Sec.	S T R	12
	S T R	

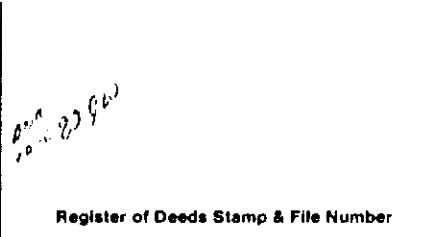

4 Lot No _____, Recorded Plat _____
 5 Private Claims _____

I, Keith Sackett, in a field survey on September 11, 19 89, do hereby certify that under requirements of P.A. 74, Michigan P.A. of 1970, the corner points mentioned in lines 1 and 2 above were in conformance with regulations and rules therefore as required in the current manual of survey instructions of the United States Department of the Interior, Bureau of Land Management or by a decree of a Court of Law and/or that the corner points mentioned in lines 3, 4 and 5 above were in conformance with the rules of the Michigan Board of Land Surveyors or by a Decree of a Court of Law, established, re-established, monumented, re-monumented, recovered, found as expressed below.

NOTE: Not more than 4 corners, all in the same town and range, may be recorded on this certificate.

	A	B	C	D	E	F	G	H	I	J	K	L	M
2	6	5	4	3	2	1							
3													
4	7	8	9	10	11	12							
5													
6	15	17	16	15	14	13							
7													
8	19	20	21	22	23	24							
9													
10	30	29	28	27	26	25							
11													
12	31	32	33	34	35	36							
13													

A Description of original monument and accessories and/or subsequent restoration:

L4	5	8	12
Not set on original survey nor subsequently, apparently.	Not set on original survey nor subsequently, apparently.	Not set on original survey nor subsequently, apparently.	Not set on original survey nor subsequently, apparently.

B Description of corner evidence found and/or method applied in restoring or reestablishing corner:

L4	5	8	12
Established at intersection of N-S and E-W 1/4 lines.	Established during section subdivision.	Established during section subdivision.	Established during section subdivision.

C Description of monument for corner and accessories established to perpetuate locating the position of the corner:

L4	5	8	12
Set 1" 10 x 36" IP with 4" aluminum cap.	Set 1" 10 x 36" IP with 4" aluminum cap.	Set 1" 10 x 36" IP with 4" aluminum cap.	Set 1" x 36" IP with 4" aluminum cap, buried in center of woods road.
14" jack pine N58E 32.6' 1/4S, BT	12" jack pine N37E 4.1' 1/16S, BT	8" jack pine N40W 1.0' squared	12" jack pine S07W 32.7' 1/16S, BT
6" jack pine N42W 18.8' 1/4S, BT	5" jack pine S42W 3.9' 1/16S, BT	7" jack pine S38W 7.6' 1/16S, BT	13" jack pine S63E 25.3' 1/16S, BT
14" white pine S13W 42.9' 1/4S, BT	10" jack pine N73W 16.3' 1/16S, BT	7" jack pine S75E 9.8' 1/16S, BT	12" jack pine N10W 39.9' 1/16S, BT
		12" jack pine N15E 18.2' 1/16S, BT	

Signed by Keith Sackett Date 9-21-89

Surveyor's Michigan License No. 19066