

REV

JUL 03 2000

MARQUETTE COUNTY MICHIGAN RECEIVED FOR RECORD

1996 NOV 22 AM 11:07

SECTION

LAND CORNER RECORDATION CERTIFICATE Filing Requirement of Act 74, Mich. P.A. 1970

For corners in Marquette (County)

Located In: Corner Code #

Table with 3 columns: Section, Located In, Corner Code #. Row 1: 1. Public Land Survey, T 51N R 28W, A13 (circled and checked), M13. Row 2: T 51N R 29W, M13. Rows 3-5: T R, T R, T R. Row 6: 2. Property Controlling in Section, S T R. Row 7: S T R. Row 8: 3. Miscellaneous Property in Sec., S T R. Row 9: S T R.

Patricia A. Mearns REGISTER OF DEEDS

LIBER R1 PAGE 317 Register of Deeds Stamp & File Number

4. Lot No. , Recorded Plat Private Claims

Sep 19 1995

I, Stephan J. Szyszkoski, in a field survey on 19 do hereby state that under requirements of P.A. 74, Michigan P.A. of 1970, the corner points mentioned in lines 1 and 2 above were in conformance with regulations and rules therefore as required in the current manual of survey instructions of the United States Department of the Interior, Bureau of Land Management or by a decree of a Court of Law and/or that the corner points mentioned in lines 3, 4 and 5 above were in conformance with the rules of the Michigan Board of Land Surveyors or by a Decree of a Court of Law; established, re-established, monumented, recovered, found as expressed below:

NOTE: Not more than 2 corners, all in the same town and range, may be recorded on this certificate.

Grid table with columns A-L and rows 1-12. Row 1: A-L. Row 2: 6, 5, 4, 3, 2, 1. Row 3: 7, 8, 9, 10, 11, 12. Row 4: 18, 17, 16, 15, 14, 13. Row 5: 19, 20, 21, 22, 23, 24. Row 6: 30, 29, 28, 27, 26, 25. Row 7: 31, 32, 33, 34, 35, 36.

A. Description of original monument and accessories and/or subsequent restoration:

(A13) Southwest corner of T51N-R28W and Southeast corner of T51N-R29W. Corner established in 1845 by Autin Burt: " West on south side of Section 31...82.00 Set post corner of Township 51 North Between Ranges 28 & 29 West. Sugar 14 N24E 42, Birch 16 N63W 30". Field book 601, pp 140-141 at Marquette Co. Road Commission offices in Ishpeming show: "SE cor. of Sec. 36-51-29 has a 3/4" iron pin and a maple post set from old B.T. Y. Birch 16 N63W 30 links. Old Sugar B.T. is gone. This Y. Birch is a broken stub "BT" scribed in old blaze is still very distinct and should be for a long time. I believe this also has been taken care of by Schjanberg. (signed) JJH Oct. 3, 1947". The undersigned does not know who Schjanberg or JJH are.

B. Description of corner evidence found and/or method applied in restoring or reestablishing corner:

(A13) Found a 3/4" dia. iron pin at record bearing and distance from the remains of the original Y. Birch bearing tree noted above. The Y. birch is now a stump in advanced stages of decay with no markings visible. Several painted and blazed trees face the corner. A second 3/4" pin, apparently marking the North 1/4 corner of Sec. 3 T50N-R29W, was found westerly 8.97' distant. Distances east to found monumented standard corner common to Sections 32-33 and to South 1/4 corner Sec. 34 check fairly well with the original record (160.703 ch. meas., 162 ch. rec. and 279.968 ch. meas., 282 ch. rec., respectively) and is consistent with original stream call 68.5 ch. east. I accepted the 3/4" iron pin as a careful and faithful perpetuation of the position of the original corner.

RATIFIED BY PEER GROUP P.A. 345 OF 1990


Larry J. Bussone DATE 10/28/96

C. Description of monument for corner and accessories established to perpetuate locating the position of the corner:

(A13) Found 3/4" iron pin. Blazed and scribed the following bearing trees: 6" Sugar N17W 13.6' "S36 NBT" 12" Sugar N60E 17.3' "S31 NBT" 5" Sugar S52W 24.7' "S3 NBT" 4" Ironwood S36E 17.7' "S3 NBT" 3/4" iron pin found West 8.97' Bearings are magnetic.

MDNR monuments are 1"IDx32" iron pipe capped with a 4" dia. cast aluminum Michigan Department of Natural Resources tablet, stamped with Township, Range, corner ID, date of placement, and "PS 33986".

New bearing trees are marked with a BH blaze and a lower blaze at the root crown. The blazes are scribed as indicated in quotation marks at left, with NBT or BT (as noted) being on the lower blaze. Distances are horizontal (unless noted) and measured from the corner to the inside of a notch cut into the bottom of the lower blaze.

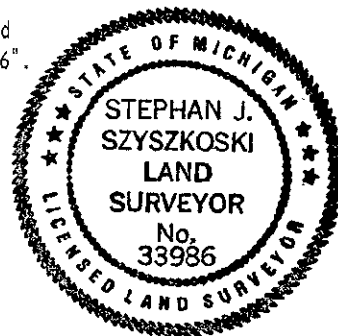

Signed by Stephan J. Szyszkoski Surveyor's Michigan License No. 33986

Date 11-5-96

For the Michigan Department of Natural Resources - Forest Management Division