

JUL 03 2000

MARQUETTE COUNTY MICHIGAN RECEIVED FOR RECORD

1996 NOV 22 AM 11: 07

SECTION

LAND CORNER RECORDATION CERTIFICATE Filing Requirement of Act 74, Mich. P.A. 1970

For corners in

Marquette

(County)

Located In:

Corner Code #

- 1. Public Land Survey T 51N R 28W 813
2. Property Controlling in Section S T R
3. Miscellaneous Property in Sec. S T R

Patricia A. Markey REGISTER OF DEEDS

LIBER R1 PAGE 318 Register of Deeds Stamp & File Number

4. Lot No. , Recorded Plat
5. Private Claims

Sep 28 1995

I, Stephan J. Szyszkoski, in a field survey on 19 do hereby state that under requirements of P.A. 74, Michigan P.A. of 1970, the corner points mentioned in lines 1 and 2 above were in conformance with regulations and rules therefore as required in the current manual of survey instructions of the United States Department of the Interior, Bureau of Land Management or by a decree of a Court of Law and/or that the corner points mentioned in lines 3, 4 and 5 above were in conformance with the rules of the Michigan Board of Land Surveyors or by a Decree of a Court of Law; established, re-established, monumented, recovered, found as expressed below:

NOTE: Not more than 2 corners, all in the same town and range, may be recorded on this certificate.

Grid table with columns A-M and rows 1-13. A dot is marked at row 13, column A.

A. Description of original monument and accessories and/or subsequent restoration:

(813) Quarter corner on the South Side of Section 31 T51N-R28W. Corner established in 1845 by Austin Burt: "40.00 Set qr. section post. Sugar 8 NE 14, Maple 8 NW 53". Found no subsequent record.

B. Description of corner evidence found and/or method applied in restoring or reestablishing corner:

(813) Original corner and accessories not recovered. Found no acceptable evidence of the position of the original corner on the ground. Reestablished the corner on the Fifth Correction Line at the proportionate North Latitude between monumented standard corners 2749.81' West and 7856.59' east, being proportionate to the original record. At the the position for the corner, I placed a 1"IDx32" iron pipe capped with a 4" dia. cast aluminum MDNR tablet, appropriately stamped. I found an old squared cedar post, apparently a forester's approximate corner, S05W 14.3' from the corner. I removed the post and placed it adjacent to the monument.

RATIFIED BY PEER GROUP P.A. 345 OF 1990

Signature and DATE 10/28/96

C. Description of monument for corner and accessories established to perpetuate locating the position of the corner:


(313) Set 1" pipe with 4" MDNR cap. Blazed and scribed the following new bearing trees:

- 18" Sugar S34W 13.3' 1/4S NBT"
20" Hemlock N72W 20.2' 1/4S NBT"
9" Hemlock N26E 33.7' 1/4S NBT"
9" Maple S84E 32.5' 1/4S NBT"

Bearings are magnetic.

MDNR monuments are 1"IDx32" iron pipe capped with a 4" dia. cast aluminum Michigan Department of Natural Resources tablet, stamped with Township, Range, corner ID, date of placement, and "PS 33986".

New bearing trees are marked with a BH blaze and a lower blaze at the root crown. The blazes are scribed as indicated in quotation marks at left, with NBT or BT (as noted) being on the lower blaze. Distances are horizontal (unless noted) and measured from the corner to the inside of a notch cut into the bottom of the lower blaze.

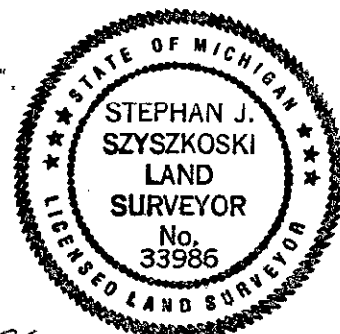

Signed by Stephan J. Szyszkoski Surveyor's Michigan License No. 33986

Date 11-5-96