


# Meander Corners

FOR PUBLIC LAND SURVEY CORNERS IN THE  
T. 32N , R. 27W (MENTIONED OVER)

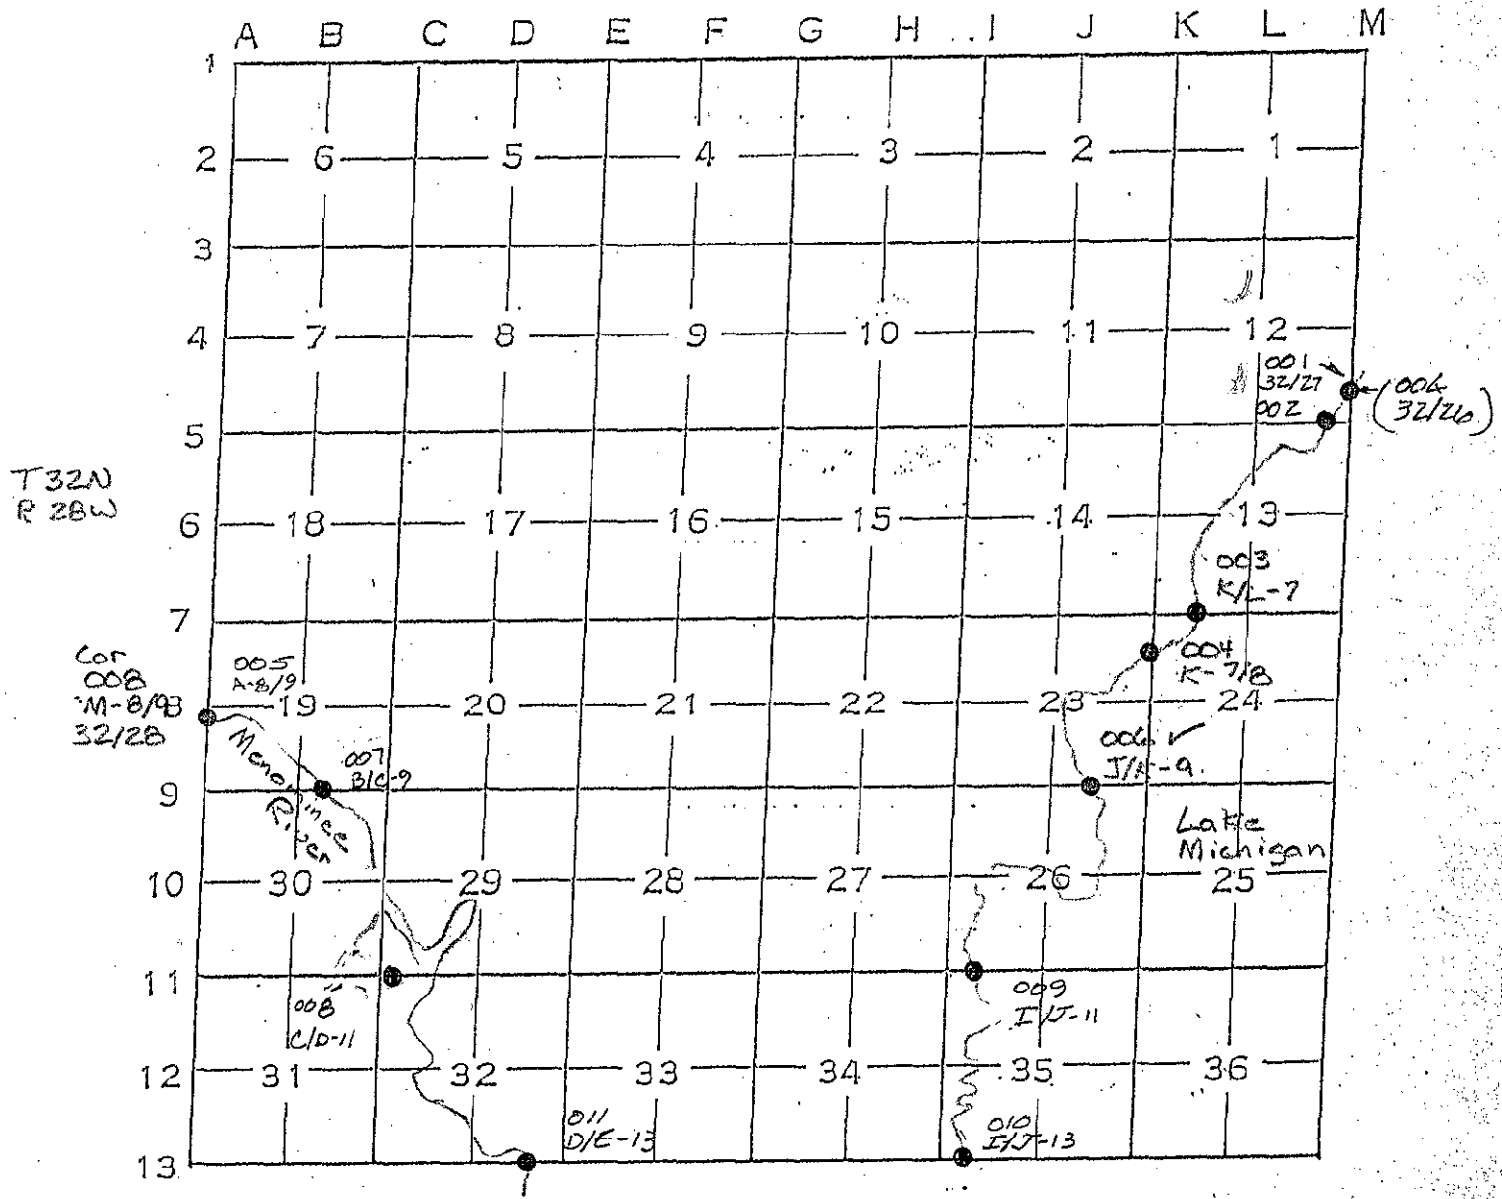

31/27

NUMBERING SYSTEM FOR MEANDER CORNERS IN T32N - R27W  
MENOMINEE TOWNSHIP, MENOMINEE COUNTY, MICHIGAN.