

1993

COMMISSIONER

LAND CORNER RECORDATION CERTIFICATE
Filing Requirement of Act 74, Mich. P.A. 1970

Approved by Menominee County
Land Survey Remonumentation
Peer Group Under Act 345 Of
P.A. Of 1990 On 12/29, 19993
Mez Anelli
Chairman

For corners in

<u>MENOMINEE</u> (County)	Located In:	Corner Code #/
1. Public Land Survey	T <u>32N</u> R <u>27W</u>	<u>C-6</u>
	T _____ R _____	_____
	T _____ R _____	_____
	T _____ R _____	_____
2. Property Controlling in Section	S _____ T _____ R _____	_____
	S _____ T _____ R _____	_____
3. Miscellaneous Property in Sec.	S _____ T _____ R _____	_____
	S _____ T _____ R _____	_____

RECEIVED FOR RECORD
93 DEC 29 PM 3:54
PAGE # 31
BARBARA MORRISON
REGISTER OF DEEDS
MENOMINEE, MI 49858

Register of Deeds Stamp & File Number

- 4. Lot No. _____, Recorded Plat _____
- 5. Private Claims _____

A	B	C	D	E	F	G	H	I	J	K	L	M
2	6	5	4	3	2	1						
3												
4	7	8	9	10	11	12						
5												
6	18	17	16	15	14	13						
7												
8	19	20	21	22	23	24						
9												
10	30	29	28	27	26	25						
11												
12	31	32	33	34	35	36						
13												

I, William Lenca, in a field survey on September, 1993, do hereby certify that under requirements of P.A. 74, Michigan P.A. of 1970, the corner points mentioned in lines 1 and 2 above were in conformance with regulations and rules therefore as required in the current manual of survey instructions of the United States Department of the Interior, Bureau of Land Management or by a decree of a Court of Law and/or that the corner points mentioned in lines 3, 4 and 5 above were in conformance with the rules of the Michigan Board of Land Surveyors or by a Decree of a Court of Law; established, re-established, monumented, re-monumented, recovered, found as expressed below:

NOTE: Not more than 4 corners, all in the same town and range, may be recorded on this certificate.

A. Description of original monument and accessories and/or subsequent restoration:

ORIGINAL B.T.'s: Tamarack, 10", N72°E, 10 lks
Tamarack, 11", S41°W, 29 lks

Original Survey by James H. Mullett in 1848. No original evidence found.

PERPETUATION: Albert Haas, County Surveyor, in a 1900 survey states "4 inch Cedar Post identified from former surveys". This survey is on record in "County Surveyors Record" Book on page 16, Menominee County Records.

B. Description of corner evidence found and/or method applied in restoring or reestablishing corner:


In a retracement of Albert Haas survey of 1900 (mentioned in A above), along the West Line of Section 17, T32N-R27W, we found a very old fence (circa early 1900's) at the South 1/16 line. The distance from the Northeast Corner of Section 17 south along an old N-S fence to this old 1/16 fence matches Haas' recorded distance. Corner C-6 was set on the old N-S fence at Haas' recorded distance south of the Northeast Corner. This corner is accepted as a careful and faithful perpetuation of the position of the original corner.

C. Description of monument for corner and accessories established to perpetuate locating the position of the corner:

Set 5/8" dia. Alum. Rod 5' long/3/4" dia. Alum. cap marked for corner:

9" dia. Tamarack	N58°W	107.28 feet
8" dia. Tamarack	S52°W	101.39 feet
6" dia. Tamarack	S07°W	57.82 feet
Metal Survey Sign Post	N05°W	7.15 feet

NOTE: All bearings are magnetic bearings; distances are measured with steel tape. distances to trees are measured to nail in side of tree.

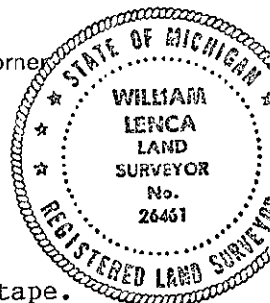

Signed by William Lenca Date December 13, 1993
Surveyor's Michigan License No. 26461