SURVEY & REMONUMENTATION
APR 1 1 1995
COMMISSION

LAND CORNER RECORDATION CERTIFICATE

Filing Requirement of Act 74, Mich. P.A. 1970

For corners in MENOMINEE (County)

	Located In:	Corner Code #
1. Public Land Survey	T 32N R 27W	C-10
	T ___ R ___	
	T ___ R ___	
	T ___ R ___	
2. Property Controlling	S ___ T ___ R ___	
in Section	S ___ T ___ R ___	
3. Miscellaneous	S ___ T ___ R ___	
Property in Sec.	S ___ T ___ R ___	

RECEIVED FOR RECORD
94 DEC 27 AM 10: 49
BARBARA MORRISON
REGISTER OF DEEDS
MENOMINEE, MI 49858
PAGE # 22 2 BK. 4

Register of Deeds Stamp & File Number

4. Lot No. _____ , Recorded Plat _____
5. Private Claims _____

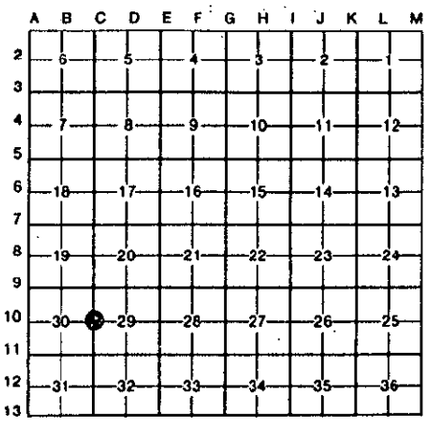

I, William Lenca, in a field survey on Mar. 07, 19 94, do hereby certify that under requirements of P.A. 74, Michigan P.A. of 1970, the corner points mentioned in lines 1 and 2 above were in conformance with regulations and rules therefore as required in the current manual of survey instructions of the United States Department of the Interior, Bureau of Land Management or by a decree of a Court of Law and/or that the corner points mentioned in lines 3, 4 and 5 above were in conformance with the rules of the Michigan Board of Land Surveyors or by a Decree of a Court of Law; established, re-established, monumented, re-monumented, recovered, found as expressed below:

NOTE: Not more than 4 corners, all in the same town and range, may be recorded on this certificate.

A. Description of original monument and accessories and/or subsequent restoration:

1847: Original Survey by James H. Mullett - B.T.'s - Birch, 10", S33°W, 22 lks; Maple, 8", S27°E, 28 lks. No original evidence for this corner was recovered.

1947: Plat of NORTH FAIRLAND PARK by T.R. Hasley, Registered Engineer, shows a tie to this corner from a plat monument. The corner monument is not described.

1954: Plat of Survey by Robert Olsen, surveyor, described this corner as a square wood stake and ties it to iron pins 318.2' East and 307.5' North.

1975: Plat of Survey by George B. Wilson, RLS No. 17607, describes this corner as a wood post and shows ties to other corners in the survey.

1981: Certified Survey No. 270 by George B. Wilson, RLS No. 17607, shows this corner as it relates to other corners in Section 29, T32N-R27W. The corner monument is not described, and no B.T.'s are given.

B. Description of corner evidence found and/or method applied in restoring or reestablishing corner:

We found a 3/4" diameter aluminum rod with a 3-1/4" diameter aluminum cap. (I have personal knowledge that George Wilson set this monument.) We found that this corner fit the position of the wood post described in Wilson's 1975 survey. The distance East to Olsen's iron pin is 319.07 feet (recorded as 318.2'). The distance East to the plat monument is 240.8' (recorded as 240'). We accepted the aluminum monument as the best available evidence of the position of the original corner.

STATE OF MICHIGAN
WILLIAM LENCA
LAND SURVEYOR
No. 26461
REGISTERED LAND SURVEYOR

C. Description of monument for corner and accessories established to perpetuate locating the position of the corner:

Accepted existing 3/4" dia. Aluminum Pipe/3-1/4" dia. Alum. Cap stamped for corner:

5/8" x 24" Iron Rod/2" cap marked WITNESS MARKER	N02°W	163.85 feet
NW Corner of Residence	N09°E	132.86 feet
SW Corner of Residence	N43°E	125.52 feet
5/8" x 24" Iron Rod/2" cap marked WITNESS MARKER	S86°W	163.45 feet
Survey Sign Post	S13°W	1.3 feet

NOTE: All bearings are magnetic bearings. All distances are measured with steel tape. Distances to trees are to nail in side of tree.

Signed by William Lenca Date Dec. 07, 1994

Surveyor's Michigan License No. 26461

FORM APPROVED BY MICHIGAN STATE BOARD OF LAND SURVEYORS, JAN. 28, 1971
REVISED MAY 14, 1975
REVISED JAN., 1983