Approved by Menominee County
Land Survey Remonumentation
Peer Group Under Act 345 Of
P.A. Of 1990 On 12/29, 1993
Chairman

RECEIVED FOR RECORD
93 DEC 29 PM 3:55
PAGE # 42 BK 4
BARBARA MORRISON
REGISTER OF DEEDS
MENOMINEE, MI 49858

Register of Deeds Stamp & File Number

LAND CORNER RECORDATION CERTIFICATE

Filing Requirement of Act 74, Mich. P.A. 1970

For corners in MENOMINEE (County)

	Located In:	Corner Code #
1. Public Land Survey	T 32N R 27W	D-1
	T ___ R ___	
	T ___ R ___	
	T ___ R ___	
2. Property Controlling	S ___ T ___ R ___	
in Section	S ___ T ___ R ___	
3. Miscellaneous	S ___ T ___ R ___	
Property in Sec.	S ___ T ___ R ___	

4. Lot No. _____, Recorded Plat _____
5. Private Claims _____

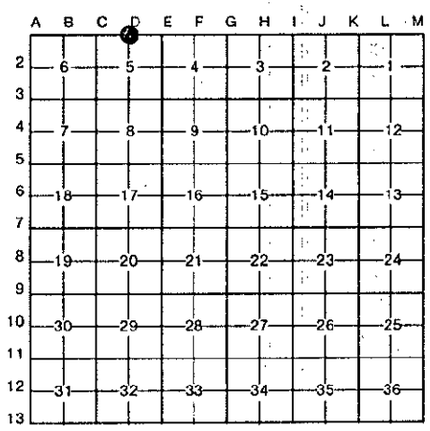

I, William Lenca, in a field survey on November, 19 93, do hereby certify that under requirements of P.A. 74, Michigan P.A. of 1970, the corner points mentioned in lines 1 and 2 above were in conformance with regulations and rules therefore as required in the current manual of survey instructions of the United States Department of the Interior, Bureau of Land Management or by a decree of a Court of Law and/or that the corner points mentioned in lines 3, 4 and 5 above were in conformance with the rules of the Michigan Board of Land Surveyors or by a Decree of a Court of Law; established, re-established, monumented, re-monumented, recovered, found as expressed below:

NOTE: Not more than 4 corners, all in the same town and range, may be recorded on this certificate.

A. Description of original monument and accessories and/or subsequent restoration:

ORIGINAL B.T.'s: Cedar, 10", N46°E, 16 lks
Spruce, 10", N65°W, 9 lks

Original Survey by James H. Mullett in 1848. All original evidence for this corner has been destroyed by farming activities.

PERPETUATION: A.L. Hillis in 1893, as recorded in field book No. 11, City of Marinette Wisconsin, Engineer's Office.

B. Description of corner evidence found and/or method applied in restoring or reestablishing corner:

Found 1½" square iron bar as described by A.L. Hillis on page 20 of field book No. 11, City Engineer's Office, City of Marinette, Wisconsin. This iron bar falls on an ancient East-West Fence. This corner was used by George B. Wilson and is shown and described in Certified Survey No. 49 of the Menominee County Records. This corner is accepted as a careful and faithful perpetuation of the position of the original corner.

C. Description of monument for corner and accessories established to perpetuate locating the position of the corner:

Set Aluminum Berntsen "F130" Drivable Cone Monument stamped for corner:

6" dia. White Ash	N85°E	43.26 feet
9" dia. White Ash	S20°W	46.36 feet
8" dia. White Ash	N69°W	31.88 feet
7" dia. White Ash	N26°W	36.17 feet
Survey Sign Post	N07°E	0.9 feet

STATE OF MICHIGAN
WILLIAM LENCA
LAND SURVEYOR
No. 26461
REGISTERED LAND SURVEYOR

NOTE: All bearings are magnetic bearings; distances are measured with steel tape; distances to trees are measured to nail in side of tree.

Signed by William Lenca Date December 2, 1993

Surveyor's Michigan License No. 26461

FORM APPROVED BY MICHIGAN STATE BOARD OF LAND SURVEYORS, JAN. 28, 1971
REVISED MAY 14, 1975
REVISED JAN., 1983