SURVEY & REMONUMENTATION

1993

COMMISSION

Approved by Menominee County Land Survey Remonumentation Peer Group Under Act 345 Of P.A. Of 1990 On 12/28, 1993

Chairman

LAND CORNER RECORDATION CERTIFICATE

Filing Requirement of Act 74, Mich. P.A. 1970

RECEIVED FOR RECORD 93 DEC 29 PM 3:53 BARBARA MORRISON REGISTER OF DEEDS MENOMINEE, MI 49858 PAGE # 19 Bk 4

Register of Deeds Stamp & File Number

For corners in

MENOMINEE (County)

	Located In:	Corner Code ##
1. Public Land Survey	T 32N R 27W	D-3
	T ___ R ___	
	T ___ R ___	
	T ___ R ___	
2. Property Controlling	S ___ T ___ R ___	
in Section	S ___ T ___ R ___	
3. Miscellaneous	S ___ T ___ R ___	
Property in Sec.	S ___ T ___ R ___	

4. Lot No. _____, Recorded Plat _____
5. Private Claims _____

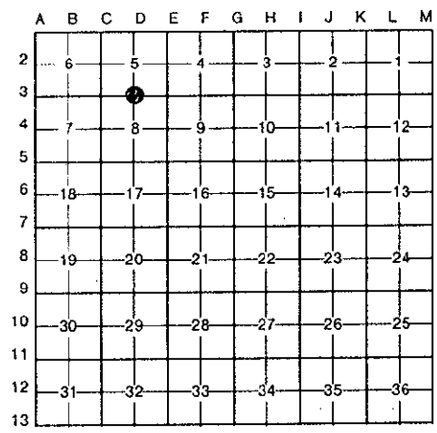

I, William Lenca, in a field survey on October, 1993, do hereby certify that under requirements of P.A. 74, Michigan P.A. of 1970, the corner points mentioned in lines 1 and 2 above were in conformance with regulations and rules therefore as required in the current manual of survey instructions of the United States Department of the Interior, Bureau of Land Management or by a decree of a Court of Law and/or that the corner points mentioned in lines 3, 4 and 5 above were in conformance with the rules of the Michigan Board of Land Surveyors or by a Decree of a Court of Law; established, re-established, monumented, re-monumented, recovered, found as expressed below:

NOTE: Not more than 4 corners, all in the same town and range, may be recorded on this certificate.

A. Description of original monument and accessories and/or subsequent restoration:

ORIGINAL B.T.'s: White Ash, 6", S52°W, 03 lks
White Ash, 6", S41°W, 20 lks

Original Survey by James H. Mullett in 1848. All original evidence for this corner has been destroyed by county road improvements.

PERPETUATION: William Lenca in 1989 - recorded in LCRC No. 847 in Book 3.

B. Description of corner evidence found and/or method applied in restoring or reestablishing corner:

Found 5/8" dia. Iron Rod/Ident. cap set by William Lenca in location indicated by information contained in Certified Survey No. 204. The corner position falls in the centerline of an East-West County Road and in line with remnants of old fence North. This corner has been used for control by local surveyors and is accepted as the best available evidence of the position of the original corner.

STATE OF MICHIGAN WILLIAM LENCA LAND SURVEYOR No. 26461 REGISTERED LAND SURVEYOR

C. Description of monument for corner and accessories established to perpetuate locating the position of the corner:

Set 5/8" x 24" Iron Rod/3¼" dia. Alum. cap stamped for corner in Monument Box:

8" dia. White Ash	S68°E	96.91 feet
8" dia. White Ash	S17°W	31.80 feet
5" dia. White Ash	N59°W	52.08 feet
6" dia. White Ash	N16°W	26.11 feet
Metal Survey Sign Post	NO2°E	27.7 feet

NOTE: All bearings are magnetic bearings; distances are measured with steel tape. distances to trees are measured to nail in side of tree.

Signed by William Lenca Date Dec. 10, 1993

Surveyor's Michigan License No. 26461

FORM APPROVED BY MICHIGAN STATE BOARD OF LAND SURVEYORS, JAN. 28, 1971
REVISED MAY 14, 1975
REVISED JAN., 1983