REMONUMENTATION

1993

COMMISSION

Approved by Menominee County Land Survey Remonumentation Peer Group Under Act 345 Of P.A. Of 1990 On 12/20, 1993

Chairman

LAND CORNER RECORDATION CERTIFICATE

Filing Requirement of Act 74, Mich. P.A. 1970

RECEIVED FOR RECORD
93 DEC 29 PM 3:53
PAGE #24 Bk. 4
BARBARA MORRISON
REGISTER OF DEEDS
MENOMINEE, MI 49858

Register of Deeds Stamp & File Number

For corners in

MENOMINEE (County)

		Located In:	Corner Code ##
1. Public Land Survey		T 32N R 27W	E-4
		T ___ R ___	
		T ___ R ___	
		T ___ R ___	
2. Property Controlling in Section	S ___	T ___ R ___	
	S ___	T ___ R ___	
3. Miscellaneous Property in Sec.	S ___	T ___ R ___	
	S ___	T ___ R ___	

4. Lot No. _____, Recorded Plat _____
5. Private Claims _____

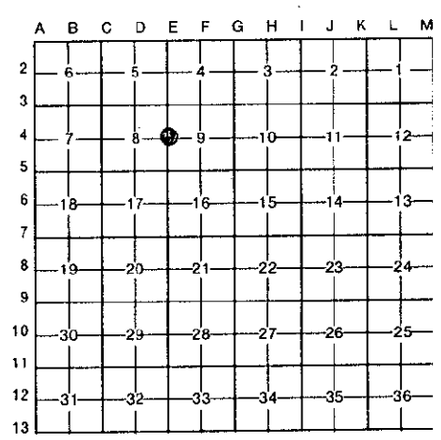

I, William Lenca, in a field survey on December, 19 93, do hereby certify that under requirements of P.A. 74, Michigan P.A. of 1970, the corner points mentioned in lines 1 and 2 above were in conformance with regulations and rules therefore as required in the current manual of survey instructions of the United States Department of the Interior, Bureau of Land Management or by a decree of a Court of Law and/or that the corner points mentioned in lines 3, 4 and 5 above were in conformance with the rules of the Michigan Board of Land Surveyors or by a Decree of a Court of Law; established, re-established, monumented, re-monumented, recovered, found as expressed below:

NOTE: Not more than 4 corners, all in the same town and range, may be recorded on this certificate.

A. Description of original monument and accessories and/or subsequent restoration:

ORIGINAL B.T.'s: Cedar, 14", S62°W, 09 lks
Cedar, 24", S38°E, 09 lks

Original Survey by James H. Mullett in 1848. All original evidence for this corner has been destroyed by county road improvements and farming activities.

PERPETUATION: This corner is shown on a Federal Aviation Agency TVOR Facility Site Plan dated 6/20/62 (Surveyor unknown). This corner is also shown in Certified Survey No. 204 by George B. Wilson in Jan. 1981.

B. Description of corner evidence found and/or method applied in restoring or reestablishing corner:

Found 1½" dia. Aluminum Pipe/2½" dia. Aluminum cap in location indicated by FAA Site Plan mentioned in "A" above. This position matches information contained in Certified Survey No. 204. Corner position falls in line with an old fence line running East from this position, and is accepted as the best available evidence of the location of the original corner.

C. Description of monument for corner and accessories established to perpetuate locating the position of the corner:

Found 1½" dia. Alum. Pipe/2½" dia. Alum. cap stamped for corner:

14" dia. White Ash	N70°E	23.73 feet
9" dia. Apple	S58°E	8.85 feet
Nail in 6"x6" Wood Post in Concrete - S21°W		31.77 feet
5/8" x 24" Iron Rod/cap 1' North of Power Pole - S88°W - 87.99 feet		

STATE OF MICHIGAN
WILLIAM LENCA
LAND SURVEYOR
No. 26461
REGISTERED LAND SURVEYOR

NOTE: All bearings are magnetic bearings; distances are measured with steel tape; distances to trees are measured to nail in side of tree.

Signed by William Lenca Date December 10, 1993

Surveyor's Michigan License No. 26461

FORM APPROVED BY MICHIGAN STATE BOARD OF LAND SURVEYORS, JAN. 28, 197
REVISED MAY 14, 197
REVISED JAN., 198