

RECORDS

1993

COMMISSION

LAND CORNER RECORDATION CERTIFICATE  
Filing Requirement of Act 74, Mich. P.A. 1970

Approved by Menominee County  
Land Survey Remonumentation  
Peer Group Under Act 345 Of  
P.A. Of 1990 On 12/20, 19993

RECEIVED FOR RECORD  
DEC 29 PM 3:54  
Clerkman  
AGE # 32  
BARBARA MORRISON  
REGISTER OF DEEDS  
MENOMINEE, MI 49858

For corners in MENOMINEE (County)

Located in: Corner Code #

1. Public Land Survey T 32N R 27W E-6

2. Property Controlling in Section S      T      R     

3. Miscellaneous Property in Sec. S      T      R     

4. Lot No.     , Recorded Plat     

5. Private Claims     

Register of Deeds Stamp & File Number

	A	B	C	D	E	F	G	H	I	J	K	L	M
2	6		5		4		3		2		1		
3													
4	7		8		9		10		11		12		
5													
6	18		17		16		15		14		13		
7													
8	19		20		21		22		23		24		
9													
10	30		29		28		27		26		25		
11													
12	31		32		33		34		35		36		
13													

I, William Lenca, in a field survey on September, 1993, do hereby certify that under requirements of P.A. 74, Michigan P.A. of 1970, the corner points mentioned in lines 1 and 2 above were in conformance with regulations and rules therefore as required in the current manual of survey instructions of the United States Department of the Interior, Bureau of Land Management or by a decree of a Court of Law and/or that the corner points mentioned in lines 3, 4 and 5 above were in conformance with the rules of the Michigan Board of Land Surveyors or by a Decree of a Court of Law; established, re-established, monumented, re-monumented, recovered, found as expressed below:

NOTE: Not more than 4 corners, all in the same town and range, may be recorded on this certificate.

A. Description of original monument and accessories and/or subsequent restoration:


ORIGINAL B.T.'s: Cedar, 9", N44°W, 09 lks  
Tamarack, 8", S33½°E, 27 lks

Original Survey by James H. Mullett in 1848. All original evidence for this corner has been destroyed by County Road improvements.

PERPETUATION: Albert Haas, County Surveyor, in a 1900 survey states: "4 inch Cedar Post in center of road identified from former surveys". This survey is on record in "County Surveyors Record" book on page 16, Menominee County Records. Certified Survey No. 269 by George B. Wilson (RLS No. 17607) shows the location of this corner as in relates to other corners in Section 16.

B. Description of corner evidence found and/or method applied in restoring or reestablishing corner:

Found a Railroad Spike set in the North side of an East-West asphalt road at a position matching information contained in Certified Survey No. 269. This position fits with an old fence running East from a position approximately 700 feet east of this location, and with a fence running south from this location. This position fits within 5 feet of Albert Haas' recorded distance south of the Northeast Corner of Section 17, T32N-R27W, and is accepted as a careful and faithful perpetuation of the position of the original corner.

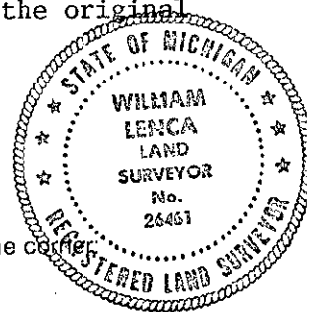

C. Description of monument for corner and accessories established to perpetuate locating the position of the corner:

Set 5/8" x 24" Iron Rod/3/4" dia. Alum. cap stamped for corner:  
5/8" x 24" Iron Rod/2" dia. Aluminum cap marked WITNESS MARKER set at the following location:  
1) N05°E 20.58 feet  
2) N72°E 39.26 feet  
3) S37°E 52.83 feet  
4) S50°W 57.65 feet  
Survey Sign Post - N05°E - 21 feet

NOTE: All bearings are magnetic bearings; distances are measured with steel tape.

Signed by William Lenca Date December 13, 1993  
Surveyor's Michigan License No. 26461