

Approved by Menominee County  
 Land Survey Remonumentation  
 Peer Group Under Act 345 Of  
 P.A. Of 1990 On 12/29 19923  
Mr. Davis  
 Chairman

COMMISSION

LAND CORNER RECORDATION CERTIFICATE  
 Filing Requirement of Act 74, Mich. P.A. 1970

For corners in


<u>MENOMINEE</u> (County)	Located In:	Corner Code #/
1. Public Land Survey	T <u>32N</u> R <u>27W</u>	<u>F-3</u>
	T _____ R _____	_____
	T _____ R _____	_____
	T _____ R _____	_____
2. Property Controlling in Section	S _____ T _____ R _____	_____
	S _____ T _____ R _____	_____
3. Miscellaneous Property in Sec.	S _____ T _____ R _____	_____
	S _____ T _____ R _____	_____
4. Lot No. _____, Recorded Plat _____		
5. Private Claims _____		

RECEIVED FOR RECORD  
 93 DEC 29 PM 3:53  
 PAGE # 21 of 24  
 BARBARA MORRISON  
 REGISTER OF DEEDS  
 MENOMINEE, MI 49853

Register of Deeds Stamp & File Number

I, William Lenca, in a field survey on September, 1993, do hereby certify that under requirements of P.A. 74, Michigan P.A. of 1970, the corner points mentioned in lines 1 and 2 above were in conformance with regulations and rules therefore as required in the current manual of survey instructions of the United States Department of the Interior, Bureau of Land Management or by a decree of a Court of Law and/or that the corner points mentioned in lines 3, 4 and 5 above were in conformance with the rules of the Michigan Board of Land Surveyors or by a Decree of a Court of Law; established, re-established, monumented, re-monumented, recovered, found as expressed below:

NOTE: Not more than 4 corners, all in the same town and range, may be recorded on this certificate.

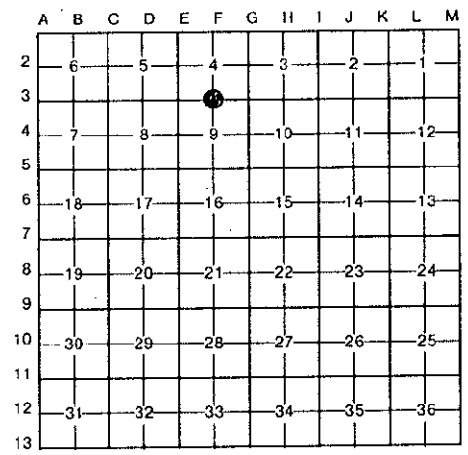

A. Description of original monument and accessories and/or subsequent restoration:

ORIGINAL B.T.'s:

- HEMLOCK, 16", N78°E, 41 lks
- HEMLOCK, 22", S76°W, 19 lks

Original Survey by James H. Mullett in 1848. All original evidence for corner F-3 has been destroyed by construction of old town road.

PERPETUATION: William Lenca in 1991 - LCRC recorded in Book 3, Page 912

B. Description of corner evidence found and/or method applied in restoring or reestablishing corner:

Found 5/8" x 24" Iron Rod/Ident. cap in center of old lane (known as "Stone Road") and in line with an old fence running south from this location. The Original Notes indicate that this corner falls 1.3 chains East of a swamp edge. The existing position of the corner fits well with this terrain call, and is accepted as the best available evidence of the position of the original corner.

C. Description of monument for corner and accessories established to perpetuate locating the position of the corner:

Set 2 1/2" x 3 3/4" x 30" Alum. Bernsten stamped for corner:

7" Cedar	N56°E	65.22 feet
18" Maple	S52°E	28.69 feet
24" White Pine	S34°W	37.76 feet
10" Cedar	N33°W	41.85 feet
Metal Survey Sign Post	SOUTH	25.00 feet



NOTE: All bearings are magnetic bearings; distances are measured with steel tape. All distances to trees are measured to nails in side of tree.

Signed by William Lenca Date December 2, 1993  
 Surveyor's Michigan License No. 26461