

SURVEY & REMONUMENTATION

OCT 26 1993


COMMISSION

LAND CORNER RECORDATION CERTIFICATE Filing Requirement of Act 74, Mich. P.A. 1970

Approved by Menominee County
Land Survey Remonumentation
Peer Group Under Act 345 Of
P.A. of 1990 On OCT 6, 199 93
McL. Davis RLS
Chairman (ACTING)

For corners in

<u>MENOMINEE</u> (County)	Located In:	Corner Code #:
1. Public Land Survey	T <u>32N</u> R <u>27W</u>	<u>G-1</u>
	T _____ R _____	_____
	T _____ R _____	_____
	T _____ R _____	_____
2. Property Controlling in Section	S _____ T _____ R _____	_____
	S _____ T _____ R _____	_____
3. Miscellaneous Property in Sec.	S _____ T _____ R _____	_____
	S _____ T _____ R _____	_____

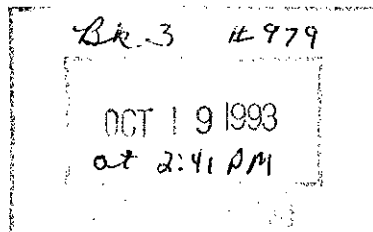

Register of Deeds Stamp & File Number

4. Lot No. _____, Recorded Plat _____
5. Private Claims _____

	A	B	C	D	E	F	G	H	I	J	K	L	M
2	6	5	4	3	2	1							
3													
4	7	8	9	10	11	12							
5													
6	18	17	16	15	14	13							
7													
8	19	20	21	22	23	24							
9													
10	30	29	28	27	26	25							
11													
12	31	32	33	34	35	36							
13													

I, William Lenca, in a field survey on July, 1993, do hereby certify that under requirements of P.A. 74, Michigan P.A. of 1970, the corner points mentioned in lines 1 and 2 above were in conformance with regulations and rules therefore as required in the current manual of survey instructions of the United States Department of the Interior, Bureau of Land Management or by a decree of a Court of Law and/or that the corner points mentioned in lines 3, 4 and 5 above were in conformance with the rules of the Michigan Board of Land Surveyors or by a Decree of a Court of Law; established, re-established, monumented, re-monumented, recovered, found as expressed below:

NOTE: Not more than 4 corners, all in the same town and range, may be recorded on this certificate.

A. Description of original monument and accessories and/or subsequent restoration:

ORIGINAL B.T.'s:

- Tamarack, 15", N48°E, 65 lks.
- Tamarack, 15", N32°W, 35 lks.

Original Survey by James H. Mullett in 1848. All original evidence for this corner has been destroyed by county road improvements.

B. Description of corner evidence found and/or method applied in restoring or reestablishing corner:

Found 5/8" dia. Iron Rod in centerline of County Road No. 320 (East-West). A corner was established in this position by George B. Wilson, RLS 17607, in a 1979 survey, and was recorded in Book 1 of Corner Records on page 198. This corner position has been used in control for several surveys in the area, and is accepted as the best available evidence of the position of the original corner.

C. Description of monument for corner and accessories established to perpetuate locating the position of the corner:

Set 5/8" dia. Iron Rod/3 1/4" dia. Alum. cap stamped for corner in Monument Box:

4" dia. Cedar	N41°E	59.78 feet
10" dia. Tamarack	S23°E	49.30 feet
9" dia. Tamarack	S45°W	51.71 feet
5" dia. White Ash	N42°W	68.90 feet
Steel Fence Post	N04°E	35.5 feet

NOTE: All bearings are magnetic bearings; distances are measured with steel tape; distances to trees are to nails in center of tree.



Signed by William Lenca Date Sept. 20, 1993
Surveyor's Michigan License No. 26461