

# SURVEY & REMONUMENTATION

OCT 26 1993


COMMISSION

Approved by Menominee County  
Land Survey Remonumentation  
Peer Group Under Act 345 Of  
P.A. of 1990 On Oct 6, 1993  
McLellan RLS  
Chairman (ALTING)

## LAND CORNER RECORDATION CERTIFICATE Filing Requirement of Act 74, Mich. P.A. 1970

For corners in

<u>MENOMINEE</u> (County)	Located In:	Corner Code #/
1. Public Land Survey	T <u>32N</u> R <u>27W</u>	<u>G-4</u>
	T _____ R _____	_____
	T _____ R _____	_____
	T _____ R _____	_____
2. Property Controlling in Section	S _____ T _____ R _____	_____
	S _____ T _____ R _____	_____
3. Miscellaneous Property in Sec.	S _____ T _____ R _____	_____
	S _____ T _____ R _____	_____
4. Lot No. _____, Recorded Plat _____		
5. Private Claims _____		

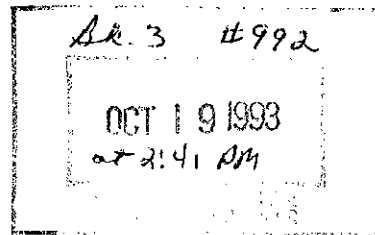

Register of Deeds Stamp & File Number

I, William Lenca, in a field survey on August, 1993 do hereby certify that under requirements of P.A. 74, Michigan P.A. of 1970, the corner points mentioned in lines 1 and 2 above were in conformance with regulations and rules therefore as required in the current manual of survey instructions of the United States Department of the Interior, Bureau of Land Management or by a decree of a Court of Law and/or that the corner points mentioned in lines 3, 4 and 5 above were in conformance with the rules of the Michigan Board of Land Surveyors or by a Decree of a Court of Law; established, re-established, monumented, re-monumented, recovered, found as expressed below:

**NOTE: Not more than 4 corners, all in the same town and range, may be recorded on this certificate.**

	A	B	C	D	E	F	G	H	I	J	K	L	M
2	6	5	4	3	2	1							
3													
4	7	8	9	10	11	12							
5													
6	18	17	16	15	14	13							
7													
8	19	20	21	22	23	24							
9													
10	30	29	28	27	26	25							
11													
12	31	32	33	34	35	36							
13													

A. Description of original monument and accessories and/or subsequent restoration:

ORIGINAL B.T.'s:

- Tamarack, 8", N41°W, 24 lks
- Cedar, 10", N20°E, 11 lks

Original Survey by James H. Mullett in 1848. No original evidence found at corner location.

B. Description of corner evidence found and/or method applied in restoring or reestablishing corner:

Found 3/4" dia. Aluminum Rod/3 1/4" dia. Aluminum cap next to remains of old squared wood post. The corner is at the intersection of very old fences which run East and South from this position. The corner monument was set by George B. Wilson, RLS No. 17607, and was recorded in Book 2 of Land Corner Records on page 374. This corner has been used for control in several surveys, and is accepted as the best available evidence of the position of the original corner.

C. Description of monument for corner and accessories established to perpetuate locating the position of the corner:

3/4" dia. Aluminum Rod/3 1/4" dia. Aluminum cap stamped for corner location:

8" dia. Tamarack	N12°E	11.78 feet
20" dia. Tamarack	N79°W	21.88 feet
9" dia. Tamarack	N88°E	23.45 feet
12" dia. Cedar	S12°E	15.68 feet
Steel Sign Post	N45°E	0.9 feet

NOTE: All bearings are magnetic bearings; all distances are measured with steel tape; distances to trees are to nails in center of tree.

Signed by William Lenca Date Sept. 22, 1993  
Surveyor's Michigan License No. 26461