Property in Sec.

1993

LAND CORNER RECORDATION CERTIFICATE Filing Requirement of Act 74, Mich. P.A. 1970

Land Sui	vey ker	попитен	HOUSE
Peer Gr	oup Und	ler Act 3	15 Of
P.A. Of 1990 On	12,	122	_ 199 <u>본</u>
11/1	IL K	Discell	i
	Chair	man	
	93	85	

Approved by Menomince County


For	r corners in		
	MENOMINEE (County)	Located In:	Corner Code ##
1.	Public Land Survey	T32N R 27W	G-6
		T R	
		T R	
		T R	
2.	Property Controlling	S T R	
	in Section	S T R	
_	MiHampaup	e T R	Į.


Register of Deeds Stamp & File Number

___ , Recorded Plat _ 4. Lot No. 5. Private Claims _

__ R _

September $_$, in a field survey on $_$ l William Lenca do hereby certify that under requirements of P.A. 74, Michigan P.A. of 1970, the corner points mentioned in lines 1 and 2 above were in conformance with regulations and rules therefore as required in the current manual of survey instructions of the United States Department of the Interior, Bureau of Land Management or by a decree of a Court of Law and/or that the corner points mentioned in lines 3, 4 and 5 above were in conformance with the rules of the Michigan Board of Land Surveyors or by a Decree of a Court of Law; established, re-established, monumented, re-monumented, recovered, found as

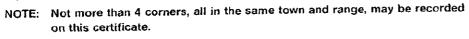

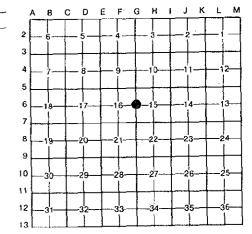

A. Description of original monument and accessories and/or subsequent restoration:

ORIGINAL B.T.'s: Tamarack, 10", S71°E, 17 1ks Tamarack, 12", N56½°W, 9 1ks

Original Survey by James H. Mullett in 1848. No original evidence found.

PERPETUATION: LCRC No. 527, Book 2 recorded by George B. Wilson in July, 1982. Certified Survey NO. 269 by George B. Wilson (RLS No. 17607) shows the location of this corner as it relates to other corners in section 16.

B. Description of corner evidence found and/or method applied in restoring or reestablishing corner:

Found 3/4" dia. Alum. Rod/34" dia. Alum. cap in location indicated from information contained in Certified Survey No. 269. This corner was placed by George B. Wilson (RLS No. 17607) in place of an old Cedar Post used by A.L. Hillis in approximately 1895. The corner falls in line with remnants of ancient fences East and South, and is accepted as the best available evidence of the position of the original corner.

C. Description of monument for corner and accessories established to perpetuate locating the position of the corner of

Found 3/4" dia. Alum. Rod/31" dia. Alum. cap stamped for corner:

, und 5/ - 4224			_		
6" dia. Black 8" dia. White 9" dia. White 20" dia. Norw Metal Survey	Pine Pine ay Pine	N16°E S85°E S20°E S58°W N73°E		13.77 21.57 18.03 13.60 0.9	feet feet

LENCA LAND SURVEYOR No. eard theo

NOTE: All bearings are magnetic bearings; distances are measured with steel tape. distances to trees are measured to nail in side of tree.

Date <u>December 13, 1993</u> Surveyor's Michigan License No. 26461 FORM APPROVED BY MICHIGAN STATE BOARD OF LAND SURVEYORS, JAN. 28, 1971