

1993

COMMISSION

LAND CORNER RECORDATION CERTIFICATE
Filing Requirement of Act 74, Mich. P.A. 1970

Approved by Menominee County
Land Survey Remonumentation
Peer Group Under Act 345 Of
P.A. of 1990 On 12/28, 199 93
MEL DAVIS
Chairman

For corners in

<u>MENOMINEE</u> (County)	Located In:	Corner Code #
1. Public Land Survey	T <u>32N</u> R <u>27W</u>	<u>G-7</u>
	T _____ R _____	_____
	T _____ R _____	_____
	T _____ R _____	_____
2. Property Controlling in Section	S _____ T _____ R _____	_____
	S _____ T _____ R _____	_____
3. Miscellaneous Property in Sec.	S _____ T _____ R _____	_____
	S _____ T _____ R _____	_____

RECEIVED FOR RECORD
93 DEC 29 PM 3:50
PAGE # 9 284 4
BARBARA MORRISON
REGISTER OF DEEDS
MENOMINEE, MI 49850

Register of Deeds Stamp & File Number

- 4. Lot No. _____, Recorded Plat _____
- 5. Private Claims _____

A	B	C	D	E	F	G	H	I	J	K	L	M
2	6	5	4	3	2	1						
3												
4	7	8	9	10	11	12						
5												
6	18	17	16	15	14	13						
7												
8	19	20	21	22	23	24						
9												
10	30	29	28	27	26	25						
11												
12	31	32	33	34	35	36						
13												

I, William Lenca, in a field survey on October, 19 93

do hereby certify that under requirements of P.A. 74, Michigan P.A. of 1970, the corner points mentioned in lines 1 and 2 above were in conformance with regulations and rules therefore as required in the current manual of survey instructions of the United States Department of the Interior, Bureau of Land Management or by a decree of a Court of Law and/or that the corner points mentioned in lines 3, 4 and 5 above were in conformance with the rules of the Michigan Board of Land Surveyors or by a Decree of a Court of Law; established, re-established, monumented, re-monumented, recovered, found as expressed below:

NOTE: Not more than 4 corners, all in the same town and range, may be recorded on this certificate.

A. Description of original monument and accessories and/or subsequent restoration:

ORIGINAL B.T.'s: Aspen, 14", N14°E, 14 lks
Birch, 12", S40°E, 07 lks

Original Survey by James H. Mullett in 1848. All original evidence for this corner has been destroyed by county road improvements.

PERPETUATION: George B. Wilson shows ties to corner G-7 in Certified Surveys No. 63, No. 64 and No. 148.


B. Description of corner evidence found and/or method applied in restoring or reestablishing corner:

Found 3/4" dia. Alum. Rod/3 1/4" dia. Alum. cap in line with centerline of County Road running East and North from this location, and in line with an old fence line running south. The monument was placed by William Lenca, RLS 26461, in place of the 1/2" dia. iron pin, which was placed by George B. Wilson and is referenced in the above mentioned Certified Surveys. The monument was placed in September of 1982. Several surveys have been made using this corner position as control, and is accepted as the best available evidence of the location of the original corner.

C. Description of monument for corner and accessories established to perpetuate locating the position of the corner:

Found 3/4" dia. Alum. Rod 5' long/3 1/4" dia. Alum. cap stamped for corner:

6" dia. Tamarack	N27°E	116.95 feet
5" dia. Cedar	S38°E	83.70 feet
6" dia. Cedar	S15°W	12.68 feet
8" dia. Cedar	S68°W	30.26 feet
Metal Survey Sign Post	South	0.8 feet

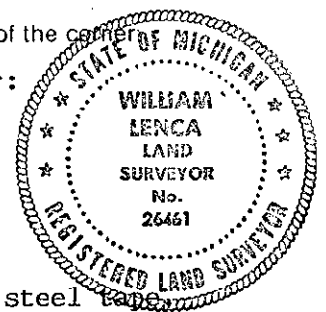

NOTE: All bearings are magnetic bearings; distances are measured with steel tape; distances to trees are measured to nail in side of tree.

Signed by William Lenca Date December 13, 1993
Surveyor's Michigan License No. 26461