

SURVEY & REMONUMENTATION COMMISSION
APR 1 1 1995

LAND CORNER RECORDATION CERTIFICATE
Filing Requirement of Act 74, Mich. P.A. 1970

Approved by Menominee County
 Land Survey Remonumentation
 Four Corners Under Act 345 of
 P.A. of 1988 On DEC 16 1994
MEL DAVIS RLS
 ACTING Chairman

For corners in MENOMINEE (County) Located In: Corner Code #

1. Public Land Survey	T <u>32NR</u> <u>27W</u>	<u>G-10</u>
	T _____	_____
	T _____	_____
	T _____	_____
2. Property Controlling in Section	S _____ T _____ R _____	_____
	S _____ T _____ R _____	_____
3. Miscellaneous Property in Sec.	S _____ T _____ R _____	_____
	S _____ T _____ R _____	_____
4. Lot No. _____, Recorded Plat _____		
5. Private Claims _____		

RECEIVED FOR RECORD
 94 DEC 27 AM 10:08
 PAGE # 191 BR-9
 BARBARA MORRISON
 REGISTER OF DEEDS
 MENOMINEE MI 49883
 Register of Deeds Stamp & File Number

A	B	C	D	E	F	G	H	I	J	K	L	M
2	6	5	4	3	2	1						
3												
4	7	8	9	10	11	12						
5												
6	16	17	16	15	14	13						
7												
8	19	20	21	22	23	24						
9												
10	30	29	28	27	26	25						
11												
12	31	32	33	34	35	36						
13												

William Lenca Nov. 22 1994
 I, _____, in a field survey on _____, 19____, do hereby certify that under requirements of P.A. 74, Michigan P.A. of 1970, the corner points mentioned in lines 1 and 2 above were in conformance with regulations and rules therefore as required in the current manual of survey instructions of the United States Department of the Interior, Bureau of Land Management or by a decree of a Court of Law and/or that the corner points mentioned in lines 3, 4 and 5 above were in conformance with the rules of the Michigan Board of Land Surveyors or by a Decree of a Court of Law; established, re-established, monumented, re-monumented, recovered, found as expressed below:

NOTE: Not more than 4 corners, all in the same town and range, may be recorded on this certificate.

- A. Description of original monument and accessories and/or subsequent restoration:
- 1847: Original Survey by James H. Mullett - B.T.'s - Birch, 10", S39°E, 14 lks; Fur, 12", S62°W, 17 lks. All original evidence for this corner has been destroyed by Airport Construction.
 - 1973: L.C.R.C. No. 66 by George B. Wilson, RLS No. 17607, states "Found iron post set by Robert Olsen; This corner has been a long established corner and used by many surveyors in years past. An iron bolt was set here in Nov. 1883 by Orson Burlingame. Wilson set a 2" x 30" IP/brass cap - TIES: 23" Elm - NW - 41.3'; 11" Basswood - West - 28.9"
 - 1977: Certified Survey No. 100 by George B. Wilson, RLS No. 17607, shows this corner as it relates to other corners in Sections 27 and 34, T32N - R27W. The corner monument is not described.


B. Description of corner evidence found and/or method applied in restoring or reestablishing corner:

In 1984-1984 Airport reconstruction destroyed this corner location. The Northwest Corner of Section 27 and the Southwest Corner of the NW1/4 - NW1/4 of Section 27 were monumented in Certified Survey No. 100, and were recovered in our 1994 remonumentation survey. We also recovered the center 1/4 of Section 27. We extended the line between the NW Corner and the N1/16 Corner on the West Line of Section 27, and doubled this distance to re-establish the position of the W1/4 Corner. The location thus established fits with the C1/4 Corner of Section 27, as monumented in Certified Survey No. 100. This corner falls in the Airport Boundary, and there is nothing nearby to witness to.

C. Description of monument for corner and accessories established to perpetuate locating the position of the corner:

Set 2-1/2" x 30" Aluminum Pipe/3-1/4" dia. Alum. cap stamped for corner:

Survey Sign Post N45°W 0.9 feet
 Nothing else nearby for ties

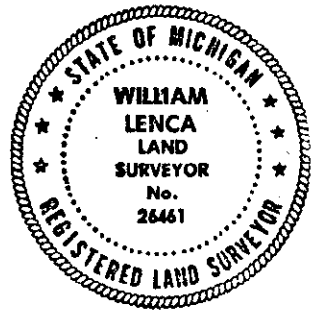

NOTE: All bearings are magnetic bearings. All distances are measured with steel tape.

Signed by William Lenca Date Dec. 15, 1994
 Surveyor's Michigan License No. 26461