

**SURVEY &
REMONUMENTATION**

OCT 26 1993

COMMISSION

Approved by Menominee County
Land Survey Remonumentation
Peer Group Under Act 345 Of

Act of 1990 On Oct 6, 1993
Mr. Davis RLS
Chairman (ACTING)

LAND CORNER RECORDATION CERTIFICATE
Filing Requirement of Act 74, Mich. P.A. 1970

For corners in

MENOMINEE Located In: Corner Code #
(County)


1. Public Land Survey T 32N R 27W I-1
T _____ R _____
T _____ R _____
T _____ R _____

2. Property Controlling S _____ T _____ R _____
in Section S _____ T _____ R _____

3. Miscellaneous S _____ T _____ R _____
Property in Sec. S _____ T _____ R _____

4. Lot No. _____, Recorded Plat _____

5. Private Claims _____

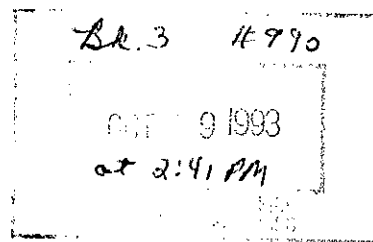

Register of Deeds Stamp & File Number

	A	B	C	D	E	F	G	H	J	K	L	M
2	6	5	4	3	2	1						
3												
4	7	8	9	10	11	12						
5												
6	18	17	16	15	14	13						
7												
8	19	20	21	22	23	24						
9												
10	30	29	28	27	26	25						
11												
12	31	32	33	34	35	36						
13												

I, William Lenca, in a field survey on August, 1993, do hereby certify that under requirements of P.A. 74, Michigan P.A. of 1970, the corner points mentioned in lines 1 and 2 above were in conformance with regulations and rules therefore as required in the current manual of survey instructions of the United States Department of the Interior, Bureau of Land Management or by a decree of a Court of Law and/or that the corner points mentioned in lines 3, 4 and 5 above were in conformance with the rules of the Michigan Board of Land Surveyors or by a Decree of a Court of Law; established, re-established, monumented, re-monumented, recovered, found as expressed below:

NOTE: Not more than 4 corners, all in the same town and range, may be recorded on this certificate.

A. Description of original monument and accessories and/or subsequent restoration:

ORIGINAL B.T.'s

- Beech, 18", N36°E, 38 lks
- Sugar, 22", N20°W, 22 lks

Original Survey by James H. Mullett in 1848 - all original evidence of this corner has been destroyed by county road improvements.

B. Description of corner evidence found and/or method applied in restoring or reestablishing corner:

Ewart Muller (RLS 15408) found a stamped brass cap (now a 2" dia. aluminum monument with a 3 1/4" dia. Aluminum cap) in a 1976 survey. The corner position is in the centerline of County Road No. 320 and 46 feet West of the Centerline of the Chicago and Northwestern Railroad, as shown on a 1877 Railroad map recorded in the Menominee County Register of Deeds Office, and is accepted as a careful and faithful perpetuation of the position of the original corner.



C. Description of monument for corner and accessories established to perpetuate locating the position of the corner:

Found 3 1/4" dia. Aluminum cap/2" Aluminum Pipe stamped for corner location:

- 5/8" x 24" Iron Rod/2" Alum. cap marked "WITNESS MARKER" - N06°E, 49.31 feet
- 3 1/2" dia. brass disc-USGS Bench Mark "D-30" - S61°E, 99.63 feet
- Northeast Corner of Tavern - S65°W, 87.53 feet
- Southeast Corner of Tavern - S36°W, 143.14 feet

NOTE: All bearings are magnetic bearings; distances measured with steel tape.

Signed by William Lenca Date Sept. 7, 1993

Surveyor's Michigan License No. 26461