

# SURVEY & REMONUMENTATION

OCT 26 1993

COMMISSION

## LAND CORNER RECORDATION CERTIFICATE Filing Requirement of Act 74, Mich. P.A. 1970

Approved by Menominee County  
Land Survey Remonumentation  
Peer Group Under Act 345 Of  
P.A. Of 1990 On OCT 6, 1993  
McDermott RLS  
Chairman (ACTING)

For corners in

MENOMINEE  
(County)

Located In: \_\_\_\_\_ Corner Code #/ # \_\_\_\_\_

1. Public Land Survey T 32N R 27W I-4

T \_\_\_\_\_ R \_\_\_\_\_

T \_\_\_\_\_ R \_\_\_\_\_


T \_\_\_\_\_ R \_\_\_\_\_

2. Property Controlling S \_\_\_\_\_ T \_\_\_\_\_ R \_\_\_\_\_  
in Section S \_\_\_\_\_ T \_\_\_\_\_ R \_\_\_\_\_

3. Miscellaneous S \_\_\_\_\_ T \_\_\_\_\_ R \_\_\_\_\_  
Property in Sec. S \_\_\_\_\_ T \_\_\_\_\_ R \_\_\_\_\_

4. Lot No. \_\_\_\_\_, Recorded Plat \_\_\_\_\_


5. Private Claims \_\_\_\_\_

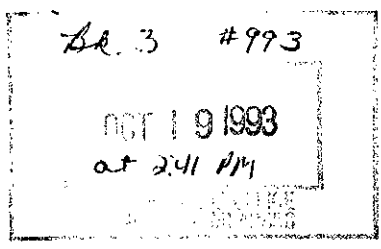

Register of Deeds Stamp & File Number

I, William Lenca, in a field survey on July, 1993, do hereby certify that under requirements of P.A. 74, Michigan P.A. of 1970, the corner points mentioned in lines 1 and 2 above were in conformance with regulations and rules therefore as required in the current manual of survey instructions of the United States Department of the Interior, Bureau of Land Management or by a decree of a Court of Law and/or that the corner points mentioned in lines 3, 4 and 5 above were in conformance with the rules of the Michigan Board of Land Surveyors or by a Decree of a Court of Law; established, re-established, monumented, re-monumented, recovered, found as expressed below:

**NOTE: Not more than 4 corners, all in the same town and range, may be recorded on this certificate.**

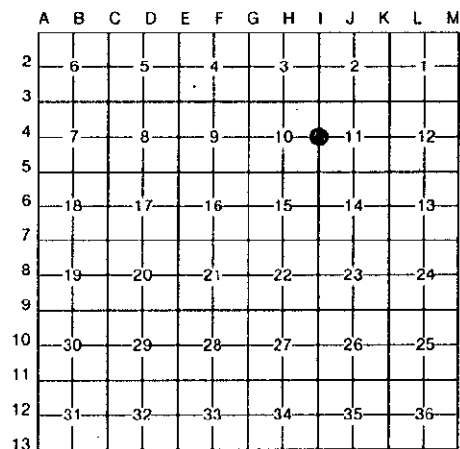

A. Description of original monument and accessories and/or subsequent restoration:

ORIGINAL B.T.'s:

Hemlock, 8" dia. for Quarter Section Post.

Original Survey by James H. Mullett in 1848. All original evidence for this corner has been destroyed by Highway improvements.

B. Description of corner evidence found and/or method applied in restoring or reestablishing corner:

Found 4" square concrete monument set on line and midway between Section Corners. This position fits well with the centerline of a county road East and old occupation line running West from this position. This corner was previously recorded in Book 2 of Land Corner records on page 532 and has been used as control for several surveys, and is accepted as a careful and faithful reestablishment of the position of the original corner.

C. Description of monument for corner and accessories established to perpetuate locating the position of the corner:

Found 4" x 4" x 36" Concrete Monument:

SE Corner of House	N57°W	60.35 feet			
5/8" x 24" Iron Rod/2" Alum. cap marked "WITNESS MARKER"			-	N32°W	- 10.78 feet
" "	" "	" "	-	S10°W	- 64.31 feet
" "	" "	" "	-	S44°E	- 117.00 feet
Steel Fence Post			-	N35°E	- 0.7 feet
Centerline U.S. Highway 41			-	East	- 41.0 feet

NOTE: All bearings are magnetic bearings; distances are measured with steel tape.

Signed by William Lenca Date Sept. 22, 1993

Surveyor's Michigan License No. 26461