

SURVEY & REMONUMENTATION

OCT 26 1993

COMMISSION

Approved by Menominee County
Land Survey Remonumentation
Peer Group Under Act 345 Of


P.A. of 1990 On OCT 6 1993

McDermis RLS
Chairman (ACTING)

LAND CORNER RECORDATION CERTIFICATE Filing Requirement of Act 74, Mich. P.A. 1970

For corners in

<u>MENOMINEE</u> <small>(County)</small>	Located In:	Corner Code: #
1. Public Land Survey	T <u>32N</u> R <u>27W</u>	<u>I-5</u>
	T _____ R _____	_____
	T _____ R _____	_____
	T _____ R _____	_____
2. Property Controlling in Section	S _____ T _____ R _____	_____
	S _____ T _____ R _____	_____
3. Miscellaneous Property in Sec.	S _____ T _____ R _____	_____
	S _____ T _____ R _____	_____
4. Lot No. _____, Recorded Plat _____		
5. Private Claims _____		

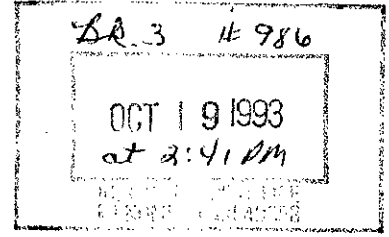

Register of Deeds Stamp & File Number

I, William Lenca, in a field survey on Sept., 19 93, do hereby certify that under requirements of P.A. 74, Michigan P.A. of 1970, the corner points mentioned in lines 1 and 2 above were in conformance with regulations and rules therefore as required in the current manual of survey instructions of the United States Department of the Interior, Bureau of Land Management or by a decree of a Court of Law and/or that the corner points mentioned in lines 3, 4 and 5 above were in conformance with the rules of the Michigan Board of Land Surveyors or by a Decree of a Court of Law; established, re-established, monumented, re-monumented, recovered, found as expressed below:

	A	B	C	D	E	F	G	H	I	J	K	L	M
2	6	5	4	3	2	1							
3													
4	7	8	9	10	11	12							
5					●								
6	18	17	16	15	14	13							
7													
8	19	20	21	22	23	24							
9													
10	30	29	28	27	26	25							
11													
12	31	32	33	34	35	36							
13													

NOTE: Not more than 4 corners, all in the same town and range, may be recorded on this certificate.

A. Description of original monument and accessories and/or subsequent restoration:

ORIGINAL B.T.'s:

- Hemlock, 14", N70°E, 54 lks
- Beech, 18", N45°W, 04 lks

Original Survey by James H. Mullett in 1848. All original evidence for this corner has been destroyed by county road improvements.

B. Description of corner evidence found and/or method applied in restoring or reestablishing corner:

Found a 4" square concrete monument in a Monument Box 2' south of centerline of Elmwood Road (East-West) and 81.8 feet West of the centerline of U.S. Highway 41. This corner was placed by George B. Wilson, RLS No. 17607, in a 1976 survey from information contained in a 1877 Railroad Map of the Chicago and Northwestern Railroad. This corner has been previously recorded in Book 1 of Land Corner Records on page 141, and is accepted as a careful and faithful perpetuation of the position of the original corner.

C. Description of monument for corner and accessories established to perpetuate locating the position of the corner:

Set 5/8" x 24" Iron Rod/3/4" dia. Alum. cap stamped for corner, in Monument Box:

- | | | |
|---|---------|---------------|
| 5/8" x 24" Iron Rod/2" dia. Alum. cap marked "WITNESS MARKER" | - N33°E | - 42.34 feet |
| " " " " " " | - S42°W | - 136.78 feet |
| " " " " " " | - N39°W | - 72.65 feet |
| Chisled cross on top of Concrete Project Marker | - N33°E | - 42.34 feet |
| Steel Fence Post | - N08°E | - 50.0 feet |

NOTE: All bearings are magnetic bearings; distances are measured with steel tape.

Signed by William Lenca Date Sept. 22, 1993

Surveyor's Michigan License No. 26461