

# SURVEY & REMONUMENTATION

OCT 26 1993


## COMMISSION

### LAND CORNER RECORDATION CERTIFICATE Filing Requirement of Act 74, Mich. P.A. 1970

Approved by Menominee County  
Land Survey Remonumentation  
Peer Group Under Act 345 Of  
P.A. Of 1990 On OCT 6 1993  
Mr. David PLS  
Chairman (ACTING)

For corners in

|   |                           |                |  |
|---|---------------------------|----------------|--|
| <u>MENOMINEE</u><br><small>(County)</small> | Located In:               | Corner Code #: |  |
| 1. Public Land Survey                       | T <u>32N</u> R <u>27W</u> | <u>J-3</u>     |  |
|   | T _____ R _____           | _____          |  |
|   | T _____ R _____           | _____          |  |
|   | T _____ R _____           | _____          |  |
| 2. Property Controlling<br>in Section       | S _____ T _____ R _____   | _____          |  |
|   | S _____ T _____ R _____   | _____          |  |
| 3. Miscellaneous<br>Property in Sec.        | S _____ T _____ R _____   | _____          |  |
|   | S _____ T _____ R _____   | _____          |  |
| 4. Lot No. _____, Recorded Plat _____       |                           |                |  |
| 5. Private Claims _____                     |                           |                |  |

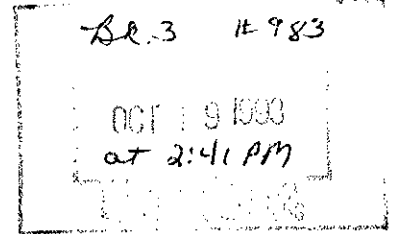

Register of Deeds Stamp & File Number

I, William Lenca in a field survey on August, 19 93, do hereby certify that under requirements of P.A. 74, Michigan P.A. of 1970, the corner points mentioned in lines 1 and 2 above were in conformance with regulations and rules therefore as required in the current manual of survey instructions of the United States Department of the Interior, Bureau of Land Management or by a decree of a Court of Law and/or that the corner points mentioned in lines 3, 4 and 5 above were in conformance with the rules of the Michigan Board of Land Surveyors or by a Decree of a Court of Law; established, re-established, monumented, re-monumented, recovered, found as expressed below:

**NOTE: Not more than 4 corners, all in the same town and range, may be recorded on this certificate.**

| A  | B  | C  | D  | E  | F  | G  | H | I | J | K | L | M |
|----|----|----|----|----|----|----|---|---|---|---|---|---|
| 2  | 6  | 5  | 4  | 3  | 2  | 1  |   |   |   |   |   |   |
| 3  |    |    |    |    |    |    |   |   | ● |   |   |   |
| 4  | 7  | 8  | 9  | 10 | 11 | 12 |   |   |   |   |   |   |
| 5  |    |    |    |    |    |    |   |   |   |   |   |   |
| 6  | 18 | 17 | 16 | 15 | 14 | 13 |   |   |   |   |   |   |
| 7  |    |    |    |    |    |    |   |   |   |   |   |   |
| 8  | 19 | 20 | 21 | 22 | 23 | 24 |   |   |   |   |   |   |
| 9  |    |    |    |    |    |    |   |   |   |   |   |   |
| 10 | 30 | 29 | 28 | 27 | 26 | 25 |   |   |   |   |   |   |
| 11 |    |    |    |    |    |    |   |   |   |   |   |   |
| 12 | 31 | 32 | 33 | 34 | 35 | 36 |   |   |   |   |   |   |
| 13 |    |    |    |    |    |    |   |   |   |   |   |   |

**A. Description of original monument and accessories and/or subsequent restoration:**

**ORIGINAL B.T.'s:**

- Cedar, 8", N35½°E, 11 lks
- Cedar, 12", S71°E, 12 lks

Original Survey by James H. Mullett in 1848. All original evidence for this corner has been destroyed by county road improvements.

**B. Description of corner evidence found and/or method applied in restoring or reestablishing corner:**

Found Berntsen Monument (sheared off by snow plow) set by William Lenca in 1981. The corner was placed in the centerline of Twin Creek Road (East-West) and in line with an old fence line running North from this position. This location fits well with 1/16 fence to the West. This corner has been used for several surveys over the past 12 years, and is accepted as the best available evidence of the position of the original corner.


Corner was previously recorded in Book 2 of Land Corner Records on page 533.

**C. Description of monument for corner and accessories established to perpetuate locating the position of the corner:**

Set 5/8" x 24" Iron Rod/3¼" Aluminum cap stamped for corner, in Monument Box:

|                   |       |            |
|-------------------|-------|------------|
| 8" dia. White Ash | N04°E | 34.51 feet |
| 6" dia. White Ash | S40°E | 57.64 feet |
| 6" dia. White Ash | S36°W | 40.70 feet |
| 4" dia. White Ash | N52°W | 76.20 feet |
| Steel Fence Post  | N02°E | 33.0 feet  |

**NOTE:** All bearings are magnetic bearings; distances are measured with steel tape; distances to trees are to nails in center of tree.

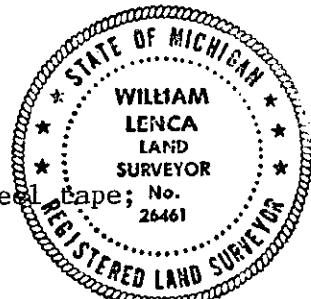

Signed by William Lenca Date Sept. 21, 1993  
Surveyor's Michigan License No. 26461