

# SURVEY & REMONUMENTATION

OCT 26 1993

COMMISSION


## LAND CORNER RECORDATION CERTIFICATE Filing Requirement of Act 74, Mich. P.A. 1970

Approved by Menominee County  
Land Survey Remonumentation  
Peer Group Under Act 345 Of

P.A. Of 1990 On OCT 6, 1993  
Mc JAVI RLS  
Chairman (ACTING)

For corners in

<u>MENOMINEE</u> <small>(County)</small>	Located In:	Corner Code #/
1. Public Land Survey	T <u>32N</u> R <u>27W</u>	<u>J-5</u>
	T _____ R _____	_____
	T _____ R _____	_____
	T _____ R _____	_____
2. Property Controlling in Section	S _____ T _____ R _____	_____
	S _____ T _____ R _____	_____
3. Miscellaneous Property in Sec.	S _____ T _____ R _____	_____
	S _____ T _____ R _____	_____

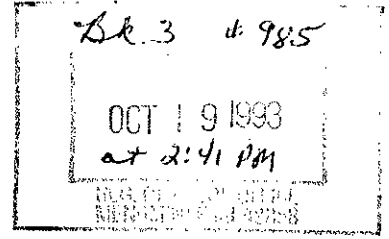

4. Lot No. \_\_\_\_\_, Recorded Plat \_\_\_\_\_

5. Private Claims \_\_\_\_\_

	A	B	C	D	E	F	G	H	I	J	K	L	M
2	6		5		4		3		2		1		
3													
4	7		8		9		10		11		12		
5									●				
6	18		17		16		15		14		13		
7													
8	19		20		21		22		23		24		
9													
10	30		29		28		27		26		25		
11													
12	31		32		33		34		35		36		
13													

I, William Lenca, in a field survey on Sept., 19 93, do hereby certify that under requirements of P.A. 74, Michigan P.A. of 1970, the corner points mentioned in lines 1 and 2 above were in conformance with regulations and rules therefore as required in the current manual of survey instructions of the United States Department of the Interior, Bureau of Land Management or by a decree of a Court of Law and/or that the corner points mentioned in lines 3, 4 and 5 above were in conformance with the rules of the Michigan Board of Land Surveyors or by a Decree of a Court of Law; established, re-established, monumented, re-monumented, recovered, found as expressed below:

**NOTE: Not more than 4 corners, all in the same town and range, may be recorded on this certificate.**

**A. Description of original monument and accessories and/or subsequent restoration:**

- ORIGINAL B.T.'s:**
- W. Pine, 12", N38°W, 05 lks
  - Hemlock, 8", S06°E, 09 lks

Original Survey by James H. Mullett in 1848. All original evidence for this corner has been destroyed by county road improvements.

**B. Description of corner evidence found and/or method applied in restoring or reestablishing corner:**

Found Railroad Spike set over 3/4" dia. hex iron (8" below pavement and bent) in the centerline of Elmwood Road (East-West) and in line with the center of a County Road running North from this location. George B. Wilson, RLS 17607, found an old Wood Stake at this location as recorded in Book 1 of Land Corner Records on page 156. This corner location has been used for control in several surveys over the past 25 years, and is accepted as the best available evidence of the position of the original corner.

**C. Description of monument for corner and accessories established to perpetuate locating the position of the corner:**

- Set 5/8" x 24" Iron Rod/3 1/4" dia. Aluminum cap stamped for corner, in Monument Box:
- |   |         |              |
|---|---------|--------------|
| 5/8" x 24" Iron Rod/2" dia. Alum. cap marked "WITNESS MARKER" | - N53°E | - 62.30 feet |
| " " " " " "   | - S26°E | - 37.92 feet |
| " " " " " "   | - S29°W | - 96.34 feet |
| " " " " " "   | - N43°W | - 53.21 feet |

**NOTE: All bearings are magnetic bearings; distances are measured with steel tape;**

Signed by William Lenca Date Sept. 21, 1993

Surveyor's Michigan License No. 26461