

SURVEY & REMONUMENTATION

OCT 26 1993

COMMISSION


LAND CORNER RECORDATION CERTIFICATE

Filing Requirement of Act 74, Mich. P.A. 1970

Approved by Menominee County
Land Survey Remonumentation
Peer Group Under Act 345 Of
P.A. Of 1990 On OCT 6, 1993
McDawis RLS
Chairman (ACTING)

For corners in

<u>MENOMINEE</u> (County)	Located In:	Corner Code #
1. Public Land Survey	T <u>32N</u> R <u>27W</u>	<u>L-5</u>
	T _____ R _____	_____
	T _____ R _____	_____
	T _____ R _____	_____
2. Property Controlling in Section	S _____ T _____ R _____	_____
	S _____ T _____ R _____	_____
3. Miscellaneous Property in Sec.	S _____ T _____ R _____	_____
	S _____ T _____ R _____	_____

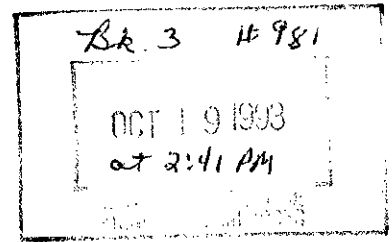

Register of Deeds Stamp & File Number

4. Lot No. _____, Recorded Plat _____
5. Private Claims _____

	A	B	C	D	E	F	G	H	I	J	K	L	M
2	6	5	4	3	2	1							
3													
4	7	8	9	10	11	12							
5													
6	18	17	16	15	14	13							
7													
8	19	20	21	22	23	24							
9													
10	30	29	28	27	26	25							
11													
12	31	32	33	34	35	36							
13													

I, William Lenca, in a field survey on August, 1993, do hereby certify that under requirements of P.A. 74, Michigan P.A. of 1970, the corner points mentioned in lines 1 and 2 above were in conformance with regulations and rules therefore as required in the current manual of survey instructions of the United States Department of the Interior, Bureau of Land Management or by a decree of a Court of Law and/or that the corner points mentioned in lines 3, 4 and 5 above were in conformance with the rules of the Michigan Board of Land Surveyors or by a Decree of a Court of Law; established, re-established, monumented, re-monumented, recovered, found as expressed below:

NOTE: Not more than 4 corners, all in the same town and range, may be recorded on this certificate.

A. Description of original monument and accessories and/or subsequent restoration:

ORIGINAL B.T.'s:

Birch, 18" dia. for Quarter Corner

Original Survey by James H. Mullett in 1848. No original evidence found.

B. Description of corner evidence found and/or method applied in restoring or reestablishing corner:

Found 3/4" dia. Alum Rod/3 1/2" dia. Alum. cap set by William Lenca, RLS 26461, from information contained in Robert Olsen's records (RLS 00751). Olsen had set an iron shaft at this location in 1954. C. Koistenen of MDOT found a 1" dia. iron pipe at this location in April of 1965. Corner falls in line with centerline of Elmwood Road (East-West) and in line with an old fence running North and South from this location. Corner position is in the center of a deep drainage ditch. This corner position has been used as control for several surveys and is accepted as the best available evidence of the original corner. This corner was previously recorded in Volume 3 of Corner Records on page 775, and in Book 2 of Corner Records on page 533.

C. Description of monument for corner and accessories established to perpetuate locating the position of the corner:

3/4" dia. Aluminum Rod/3 1/2" dia. Aluminum cap stamped for corner:

6" dia. Cedar	S11°W	35.00 feet
11" dia. Maple	S37°W	26.18 feet
7" dia. Cedar	N72°W	22.70 feet
5" dia. White Ash	N32°W	34.20 feet
Steel Fence Post	North	1.0 feet



NOTE: All bearings are magnetic bearings; all distances are measured with steel tape, distances to trees are to nail in center of tree.

Signed by William Lenca Date Sept. 20, 1993.

Surveyor's Michigan License No. 26461