


Meander Corners (✓ indicates completed & entered in remon. datab.)

FOR PUBLIC LAND SURVEY CORNERS IN THE

T. 32 N , R. 28 W (MENTIONED OVER)

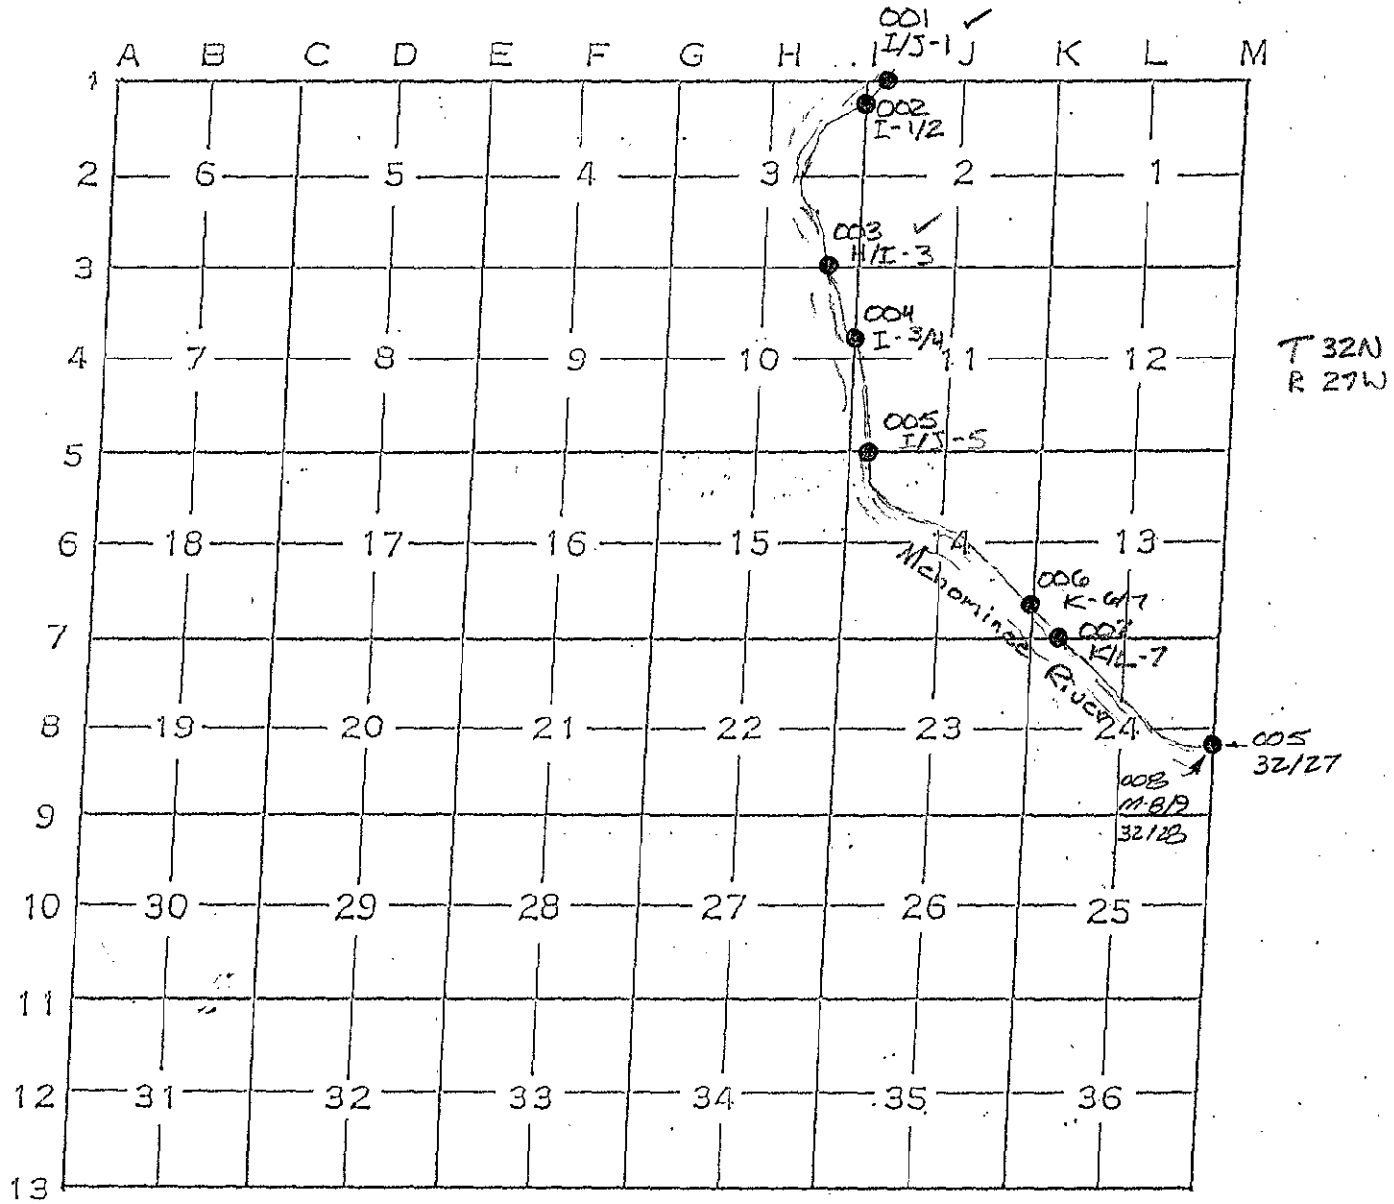

JUL 22 1996