

SURVEY & REMONUMENTATION

JUN 23 1994

COMMISSION

LAND CORNER RECORDATION CERTIFICATE Filing Requirement of Act 74, Mich. P.A. 1970

Approved by Menominee County
Land Survey Remonumentation
Peer Group Under Act 345 Of

P.A. Of 1990 On 5/18 1994

Mc Davis
Chairman

For corners in
MENOMINEE

(County)

Located In:

Corner Code **##**

- | | | |
|------------------------------------|---------------------------|------------|
| 1. Public Land Survey | T <u>32N</u> R <u>28W</u> | <u>K-2</u> |
| | T _____ R _____ | _____ |
| | T _____ R _____ | _____ |
| | T _____ R _____ | _____ |
| 2. Property Controlling in Section | S _____ T _____ R _____ | _____ |
| | S _____ T _____ R _____ | _____ |
| 3. Miscellaneous Property in Sec. | S _____ T _____ R _____ | _____ |
| | S _____ T _____ R _____ | _____ |

RECEIVED FOR RECORD
94 MAY 20 PM 3:30
PAGE #57 BK 4
BARBARA MORRISON
REGISTER OF DEEDS
MENOMINEE MI 49858
Register of Deeds Stamp & File Number

4. Lot No. _____, Recorded Plat _____
5. Private Claims _____

I, William Lenca, in a field survey on Mar. 15, 1994, do hereby certify that under requirements of P.A. 74, Michigan P.A. of 1970, the corner points mentioned in lines 1 and 2 above were in conformance with regulations and rules therefore as required in the current manual of survey instructions of the United States Department of the Interior, Bureau of Land Management or by a decree of a Court of Law and/or that the corner points mentioned in lines 3, 4 and 5 above were in conformance with the rules of the Michigan Board of Land Surveyors or by a Decree of a Court of Law; established, re-established, monumented, re-monumented, recovered, found as expressed below:

NOTE: Not more than 4 corners, all in the same town and range, may be recorded on this certificate.

A	B	C	D	E	F	G	H	I	J	K	L	M
2	6	5	4	3	2	1						
3												
4	7	8	9	10	11	12						
5												
6	18	17	16	15	14	13						
7												
8	19	20	21	22	23	24						
9												
10	30	29	28	27	26	25						
11												
12	31	32	33	34	35	36						
13												

A. Description of original monument and accessories and/or subsequent restoration:


ORIGINAL B.T.'s: Hemlock, 12", S81°E, 10 lks
W. Pine, 18", S89°W, 34 lks

Original Survey by James H. Mullett in 1848. All original evidence for this corner has been destroyed by logging activities.

PERPETUATION:

B. Description of corner evidence found and/or method applied in restoring or reestablishing corner:

Set corner in line with an old fence line running East, and in line with the centerline of old lanes running North and West from this location. A search of this area produced no evidence to dispute the location of the old fence and lanes. This corner was accepted as the best available evidence of the position of the original corner.

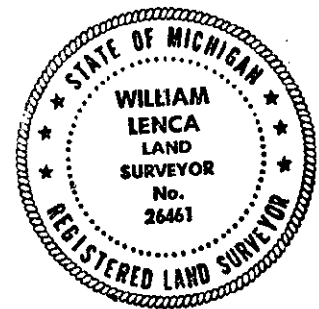

C. Description of monument for corner and accessories established to perpetuate locating the position of the corner:
Set 5/8" dia. Alum. Rod 3' long / 3-1/4" dia. Alum. cap stamped for corner:

12" dia. Norway Pine	Scr. NBT	N55°E	68.20 feet
10" dia. Maple	" "	S34°E	57.13 feet
9" dia. White Ash	" "	S29°W	25.18 feet
6" dia. Oak	" "	N54°W	79.90 feet
Survey Sign Post	" "	South	0.9 feet

NOTE: All bearings are magnetic bearings. All distances are measured with steel tape. Distances to trees are to nail in side of tree.

Signed by William Lenca Date April 16, 1994

Surveyor's Michigan License No. 26461