## LAND CORNER RECORDATION CERTIFICATE

**Filing Requirement of Act 74, Mich. P.A. 1970**

For corners in

Menominee
(County)

| | | Located In: | Corner Code # |
|---|---|---|---|
| 1. Public Land Survey | | T 33N R 26W | C-4 |
| | | T 33N R 26W | D-5 |
| | | T R | |
| | | T R | |
| 2. Property Controlling | S 8 | T 33N R 26W | 16 |
| in Section | S. | T R | |
| 3. Miscellaneous | S. | T R | |
| Property in Sec | S. | T R | |

**Register of Deeds Stamp & File Number**

4. Lot No. _____, Recorded Plat _____

5. Private Claims _____

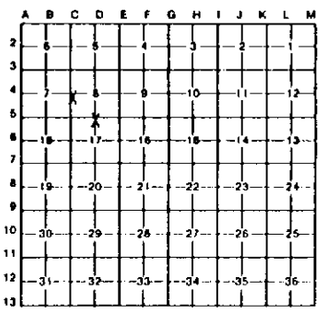


I, Gerald L. Wiggins, in a field survey on 6-6 & 6-11, 19 90, do hereby certify that under requirements of P.A. 74, Michigan P.A. of 1970, the corner points mentioned in lines 1 and 2 above were in conformance with regulations and rules therefore as required in the current manual of survey instructions of the United States Department of the Interior, Bureau of Land Management or by a decree of a Court of Law and/or that the corner points mentioned in lines 3, 4 and 5 above were in conformance with the rules of the Michigan Board of Land Surveyors or by a Decree of a Court of Law, established, re-established, monumented, re-monumented, recovered, found as expressed below.

**NOTE: Not more than 4 corners, all in the same town and range, may be recorded on this certificate.**

A. Description of original monument and accessories and/or subsequent restoration:

C-4 Quarter Corner common to Sections 7 and 8. OBT'S: Cedar 18", N34°W, 13 lks. & Cedar 12", N23°E, 9 lks.

D-5 Quarter Corner common to Sections 8 and 17. OBT'S: W. Pine 12", S54°W, 11 lks. & Birch 8, N25°W, 8 lks.

16 East 1/16 Corner common to Sections 8 and 17. Not previously set.

B. Description of corner evidence found and/or method applied in restoring or reestablishing corner:

C-4 Corner set a very old squared stake in old north and south fence line. A cedar stump with lower notch and blaze, (no scribe marks visible), fits original, a cedar 18", N34°W, 13 lks. Interior fences and farmed area fit this location. This position makes the North 1/2 mile 2643.82' and the south 1/2 mile 2918.89'.

D-5 Corner set M.P.O.L. between southwest corner and southeast corner of Section 8. A 4" Concrete monument bears north 97.75'. Could not find any record of who set this monument.

16 Corner set M.P.O.L. between south 1/4 corner and southeast corner of Section 8. A 4" Concrete monument bears north 48.55'. Could not find any record of who set this monument.

C. Description of monument for corner and accessories established to perpetuate locating the position of the corner.

DNR MONUMENT SET AT ALL THREE CORNERS.

C-4 5" B. Ash, N15°E, 34.4' & 8" B. Ash, S82°E, 35.05' & 5" Maple, S46°W, 67.5' & 8" Spruce, N79°W 76.85'

D-5 6" Maple, N28°E, 30.8' & 5" Maple, S51°E, 18.1' & 5" Maple, S48°W, 37.15' & 8" Maple, N46°W, 43.45'

16 4" Cedar, N42°E, 38.3' & 12" Cedar, S6°W, 14.2' & 4" Cedar, S69°W, 6.6' & 8" Cedar, N55°W, 42.95'

Signed by Gerald L. Wiggins Date 9-4-90

Gerald L. Wiggins

Surveyor's Michigan License No. 23521

STATE OF MICHIGAN
GERALD L. WIGGINS
LAND SURVEYOR
No. 23521
REGISTERED LAND SURVEYOR

FORM APPROVED BY MICHIGAN STATE BOARD OF LAND SURVEYORS, JAN. 26, 1971
REVISED MAY 19, 1975
REVISED JAN., 1983