

SURVEY & REMONUMENTATION

JAN 09 2001

SECTION

LAND CORNER RECORDATION CERTIFICATE
Filing Requirement of Act 74, Mich. P.A. 1970

Approved by Menominee County
Land Survey Remonumentation
Peer Group Under Act 345 of
P.A. Of 1990 On 12/22, 2000
Mike Bruhl RLS
Chairman

For corners in
MENOMINEE
(County)

Located In:	Corner Code #
T 33NR 26W	C-07
T R	
T R	
T R	
S T R	
S T R	
S T R	
S T R	


- 1. Public Land Survey
- 2. Property Controlling in Section
- 3. Miscellaneous Property in Sec.
- 4. Lot No. _____, Recorded Plat _____
- 5. Private Claims _____

Bk 6 Pg. 207

RECEIVED FOR RECORD
28 DEC 2000 2:31:31 PM
BARBARA MORRISON
REGISTER OF DEEDS
MENOMINEE, MI 49858

Register of Deeds Stamp & File Number

I, William Lenca, in a field survey on Oct, 1900 do hereby state that under requirements of P.A. 74, Michigan P.A. of 1970, the corner points mentioned in lines 1 and 2 above were in conformance with regulations and rules therefore as required in the current manual of survey instructions of the United States Department of the Interior, Bureau of Land Management or by a decree of a Court of Law and/or that the corner points mentioned in lines 3, 4 and 5 above were in conformance with the rules of the Michigan Board of Land Surveyors or by a Decree of a Court of Law; established, re-established, monumented, recovered, found as expressed below:

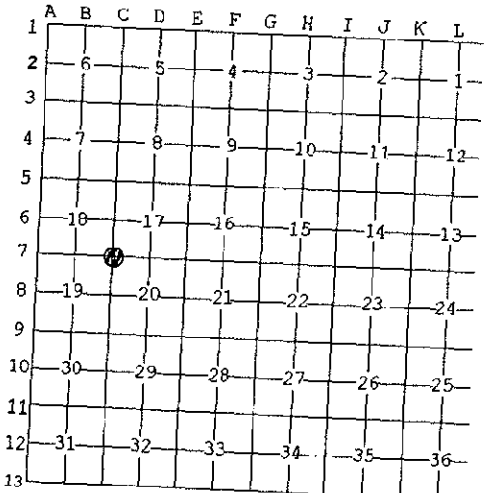

NOTE: Not more than 2 corners, all in the same town and range, may be recorded on this certificate.

A. Description of original monument and accessories and/or subsequent restoration:

- 1848: Original Survey by James H. Mullett - B.T.'s - 18" Cedar, N32°W, 13 lks; 10" Cedar, S42°E, 12 lks. Both BT's still evident.
- 1983: L.C.R.C. No. 572, Book 2, by George B. Wilson, RLS No. 17607 states set 4" diameter aluminum HDR Berntsen Monument, LOGO: Menominee County Survey Corner. Stump of BT N32°W, 13 links: found with blaze in charred wood base at SE side of old rotted stump. Stump of BT S42°E, 12 links: found old rotted frag. of stump. TIES: Silver Deep-1 Magnet, N32°W, 8.75'; Silver Deep-1 Magnet, S42°E, 6.10'.

B. Description of corner evidence found and/or method applied in restoring or reestablishing corner:

We found an HDR 5" Berntsen Monument with 3-1/4" diameter aluminum cap in place per L.C.R.C. No. 572. Since this corner was re-set from the original BT's, we accepted the position of the existing monument as a careful and faithful perpetuation of the position of the original corner. Measurements to corners 1/2 mile in 4 directions fit well.



C. Description of monument for corner and accessories established to perpetuate locating the position of the corner:

Accepted existing 3/4" x 5' long aluminum rod/3-1/4" dia. Alum. cap stamped for corner:

8" dia. White Ash	N52°E	37.67 feet	Scr. NBT
10" dia. White Ash	S25°E	26.51 feet	Scr. NBT
10" dia. Elm	S72°W	44.46 feet	Scr. NBT
12" dia. White Ash	N18°W	36.46 feet	Scr. NBT
Metal Survey Sign Post	N10°E	1.0 feet	

NOTE: All bearings are magnetic bearings. All distances are measured with steel tape. Distances to trees are to nail in side of tree.

Signed by William Lenca
Surveyor's Michigan License No. 26461

Date Dec. 13, 2000