

SURVEY & REMONUMENTATION

JAN 09 2001

SECTION

LAND CORNER RECORDATION CERTIFICATE Filing Requirement of Act 74, Mich. P.A. 1970

Approved by Menominee County
Land Survey Remonumentation
Peer Group Under Act 345 of
P.A. of 1990 On 12/22, 2000
McL Davis RLS
Chairman

For corners in

MENOMINEE

(County)

Located in:

Corner Code #

1. Public Land Survey	T	<u>33N</u>	R	<u>26W</u>	E-9
	T	___	R	___	___
	T	___	R	___	___
	T	___	R	___	___
2. Property Controlling in Section	S	___	T	___	R
	S	___	T	___	R
3. Miscellaneous Property in Sec.	S	___	T	___	R
	S	___	T	___	R

Bk. 6 Pg. 215


RECEIVED FOR RECORD
28 DEC 2000 2:31:31 PM
BARBARA MORRISON
REGISTER OF DEEDS
MENOMINEE, MI 49858

Register of Deeds Stamp & File Number

4. Lot No. _____, Recorded Plat _____
5. Private Claims _____

I, William Lenca, in a field survey on Nov., 1900 do hereby state that under requirements of P.A. 74, Michigan P.A. of 1970, the corner points mentioned in lines 1 and 2 above were in conformance with regulations and rules therefore as required in the current manual of survey instructions of the United States Department of the Interior, Bureau of Land Management or by a decree of a Court of Law and/or that the corner points mentioned in lines 3, 4 and 5 above were in conformance with the rules of the Michigan Board of Land Surveyors or by a Decree of a Court of Law; established, re-established, monumented, recovered, found as expressed below:

NOTE: Not more than 2 corners, all in the same town and range, may be recorded on this certificate.

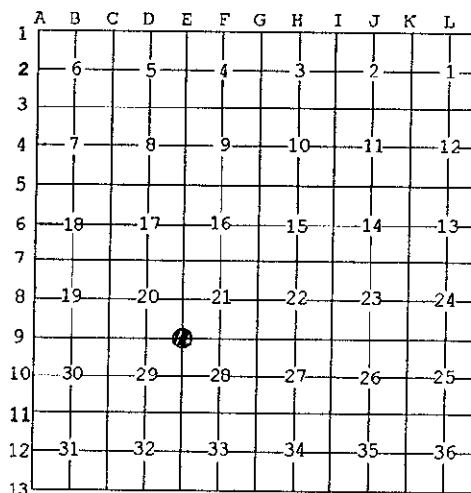

A. Description of original monument and accessories and/or subsequent restoration:

- 1848: Original Survey by James H. Mullett - B.T.'s - Cedar, 10" - S40°E - 12 lks.; Cedar, 10" - N28°W - 13 lks.; All original evidence for this corner has been destroyed.
- 1974: L.C.R.C. No. 83 by George W. Wilson, RLS No. 17607 states "Existing old cedar post with old channel iron used by Robt. Olsen-RLS MICH for corner in previous survey to the east. Used this corner rather than double proportion". Set 2" dia. pipe filled with concrete, capped with brass screw on cover and stamped with corner designation, anchored at bottom. TIES: NE House Corner - NW 74.58'; SE House Corner - SW 59.33'.
- 1987: Certified Survey #510, Book 4, by William Lenca, RLS No. 26461 shows corner E-9 in relation to other corners in Section 21, T33N - R26W.


B. Description of corner evidence found and/or method applied in restoring or reestablishing corner:

We found 2" diameter iron pipe filled with concrete and bent with the brass cap sheared off. We re-set the corner from ties per L.C.R.C. No. 83 (see part A above). This corner position falls in line with the centerline of county roads East and North, fits well with measurements to other corners in the area, has been accepted and used by local surveyors for many years, and is accepted as the best available evidence of the position of the original corner.

C. Description of monument for corner and accessories established to perpetuate locating the position of the corner:

Set 2" dia. Aluminum Pipe 30" long/3-1/4" dia. Alum cap stamped for corner location:

10" dia. Elm	N36°E	77.98 feet	Scr. N.B.T.
5/8" x 24" Iron Rod/2" dia. Alum. cap marked "WITNESS MARKER"	S46°E	26.44 feet	1.0' S. of Power Pole
6" dia. Hemlock	S07°E	12.62 feet	Scr. N.B.T.
5/8" x 24" Iron Rod/2" dia. Alum. cap marked "WITNESS MARKER"	S73°W	18.00 feet	1.0' S. of 7" Cedar
Metal Survey Sign Post	S75°E	5.3 feet	

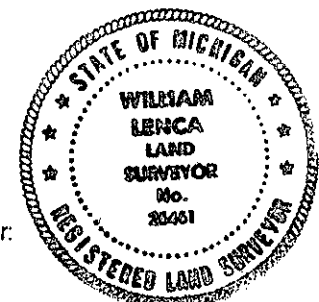

NOTE: All bearings are magnetic bearings. All distances are measured with steel tape. Distances to trees are to nail in side of tree.

Signed by William Lenca
Surveyor's Michigan License No. 26461

Date Dec. 20, 2000

215