Approved by Menominee County
Land Survey Remonumentation
Peer Group Under Act 345 Of
P.A. Of 1990 On 12/12 1996
M. Davis RLS
Chairman

LAND CORNER RECORDATION CERTIFICATE
Filing Requirement of Act 74, Mich. P.A. 1970

For corners in

MENOMINEE (County) Located In: Corner Code #

1. Public Land Survey		T33N R 27W	A03
		T___ R___	
		T___ R___	
		T___ R___	
2. Property Controlling in Section	S___	T___ R___	
3. Miscellaneous Property in Sec.	S___	T___ R___	
	S___	T___ R___	

96 DEC 20 AM 9:25
PAGE # 408, BK 5
RECEIVED FOR RECORD
REGISTER OF DEEDS
MENOMINEE COUNTY, MICH.

Register of Deeds Stamp & File Number

4. Lot No. _____, Recorded Plat _____
5. Private Claims _____

SAME AS CORNER M-03 T33N-R28W

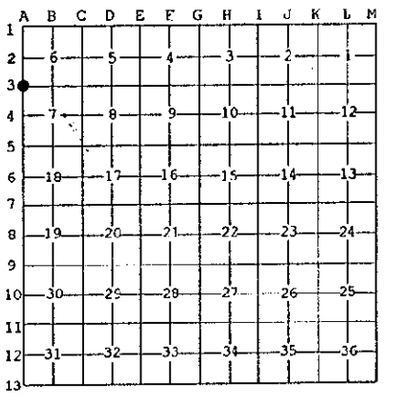

I, William Lenca, in a field survey on Aug. 20, 19 96 do hereby state that under requirements of P.A. 74, Michigan P.A. of 1970, the corner points mentioned in lines 1 and 2 above were in conformance with regulations and rules therefore as required in the current manual of survey instructions of the United States Department of the Interior, Bureau of Land Management or by a decree of a Court of Law and /or that the corner points mentioned in lines 3, 4 and 5 above were in conformance with the rules of the Michigan Board of Land Surveyors or by a Decree of a Court of Law; established, re-established, monumented, recovered, found as expressed below:

NOTE: Not more than 2 corners, all in the same town and range, may be recorded on this certificate.

A. Description of original monument and accessories and/or subsequent restoration:

1847: Original Survey (Twp Bdy) by James H. Mullett - B.T.'s - W. Pine, 18" - N53°W - 39 lks; W. Pine, 12" - S81°W - 55 lks. All original evidence for this corner has been destroyed by county road improvements.

1848: Original Survey (Sec. Subd) by John Mullett - B.T.'s - Hemlock, 9" - S53°E - 20 lks; W. Pine, 14" - N54°E - 28 lks. All original evidence for this corner has been destroyed by county road improvements.

1981: L.C.R.C. No. 332, Book 2 recorded by George B. Wilson, RLS No. 17607, states Found old iron pin set by R. Olsen in road in line with centerline of road East. Existing iron matches GLO calls to Shore West and to Sec. Cor. East and hump in ground in approx. location of W. Pine S81°W, 55 links. Set Berntsen W-4 Monument in Road Centerline. WITNESSES: Deep-1 - NW - 26.60'; Deep-1 - SW - 20.90'. Back of form indicates R. Olsen found a wood post in this position in 1935.

B. Description of corner evidence found and/or method applied in restoring or reestablishing corner:

We found a Berntsen W-1-B Monument in the centerline of River Road and in line with the centerline of a county Road running East and also Deep-1 magnets NW, 26.60 feet and SW, 20.90 feet. This corner has been accepted and used by local surveyors for at least 60 years, and is accepted as the best available evidence of the position of the original corner.

STATE OF MICHIGAN
WILLIAM LENCA
LAND SURVEYOR
No. 26461
REGISTERED LAND SURVEYOR

C. Description of monument for corner and accessories established to perpetuate locating the position of the corner:
Accepted existing Berntsen W-1-B Monument/4" dia. Alum. cap stamped for corner location:

5/8" x 24" Iron Rod/2" dia. Alum. cap marked "WITNESS MARKER"	N47°E	43.63 feet	1' N. of Power Pole
5" dia. White Pine	S15°W	78.92 feet	Scr. NBT
3/4" dia. Iron Rod	N88°W	33.01 feet	
3-1/2" dia. Pipe for Gate Post	N42°W	60.91 feet	
Metal Survey Sign Post	N88°W	33.4 feet	

NOTE: All bearings are magnetic bearings. All distances are measured with steel tape. Distances to trees are to nail in side of tree.

Signed by William Lenca Date Nov. 18, 1996
Surveyor's Michigan License No. 26461

FORM APPROVED BY MICHIGAN STATE BOARD OF PROFESSIONAL SURVEYORS, JAN. 28, 1971
REVISED MAY 14,1975
REVISED JAN., 1983
REVISED OCT., 1985

408