

LAND CORNER RECORDATION CERTIFICATE
 Filing Requirement of Act 74, Mich. P.A. 1970

For corners in MENOMINEE (County) Located In: Corner Code =##

1. Public Land Survey	T <u>33N</u> R <u>27W</u>	<u>B-09</u>
	T _____ R _____	_____
	T _____ R _____	_____
	T _____ R _____	_____
2. Property Controlling in Section	S _____ T _____ R _____	_____
	S _____ T _____ R _____	_____
3. Miscellaneous Property in Sec.	S _____ T _____ R _____	_____
	S _____ T _____ R _____	_____

4. Lot No. _____, Recorded Plat _____
 5. Private Claims _____

RECEIVED FOR RECORD
 94 DEC 12 AM 8:59
 ACTING PAGE # 109 BK 4
 BARBARA MORRISON
 REGISTER OF DEEDS
 MENOMINEE MI 49838
 Register of Deeds Stamp & File Number


A	B	C	D	E	F	G	H	I	J	K	L
2	6	5	4	3	2	1					
3											
4	7	8	9	10	11	12					
5											
6	18	17	16	15	14	13					
7											
8	19	20	21	22	23	24					
9	●										
10	30	29	28	27	26	25					
11											
12	31	32	33	34	35	36					
13											

William Lenca May 20 94
 I, _____, in a field survey on _____, 19_____, do hereby certify that under requirements of P.A. 74, Michigan P.A. of 1970, the corner points mentioned in lines 1 and 2 above were in conformance with regulations and rules therefore as required in the current manual of survey instructions of the United States Department of the Interior, Bureau of Land Management or by a decree of a Court of Law and/or that the corner points mentioned in lines 3, 4 and 5 above were in conformance with the rules of the Michigan Board of Land Surveyors or by a Decree of a Court of Law; established, re-established, monumented, re-monumented, recovered, found as expressed below:

NOTE: Not more than 4 corners, all in the same town and range, may be recorded on this certificate.

- A. Description of original monument and accessories and/or subsequent restoration:
 1848: Original Survey by John Mullett - B.T.'s - Cedar, 16" - N81°E - 16 lks; Tamarack, 10" - S22°E - 45 lks. All original evidence for this corner has been destroyed by County Road improvements.
 1988: L.C.R.C. No. 814 by William Lenca, RLS No. 26461, states that a Railroad Spike was set on line between Section Corners and in line with an old fence to the North. B.T.'s - Power Pole - S30°W - 40.65'; 6" Cedar - S78°W - 134.05'; 6" Tam. - N07°E - 48.58'

B. Description of corner evidence found and/or method applied in restoring or reestablishing corner:
 We found the railroad spike and B.T.'s set in our 1988 survey in good condition. No new evidence was found at the corner location. We therefore accepted the railroad spike as the best available evidence of the position of the original corner.

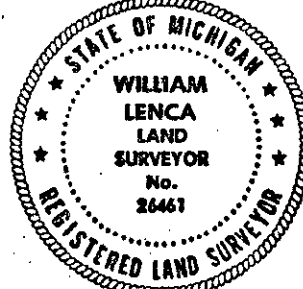

C. Description of monument for corner and accessories established to perpetuate locating the position of the corner:

Set 5/8" x 24" Iron Rod/3-1/4" dia. Alum. cap stamped for corner location in Monument Box:

6" dia. Tamarack - (Ex. B.T.)	N03°E	48.60 feet	Scr. NBT
9" dia. Tamarack	S33°E	98.70 feet	Scr. NBT
7" dia. Cedar	S31°W	55.45 feet	Scr. NBT
5/8" x 24" Iron Rod/2" dia. Alum. cap - WITNESS MARKER	N54°W	61.73 feet	
Survey Sign Post	N54°W	62.0 feet	

NOTE: All bearings are magnetic bearings. All distances are measured with steel tape. Distances to trees are to nail in side of tree.

Signed by William Lenca Date Nov. 18, 1994
 Surveyor's Michigan License No. 26461