

SURVEY & REMONUMENTATION

MAY 28 1997

COMMISSION

LAND CORNER RECORDATION CERTIFICATE
Filing Requirement of Act 74, Mich. P.A. 1970

Approved by Menominee County
Land Survey Remonumentation
Peer Group Under Act 345 Of
P.A. Of 1990 On 12/21, 1996
Mc Lewis RLS
Chairman

For corners in

<u>MENOMINEE</u> (County)	Located In:	Corner Code #
1. Public Land Survey	<u>T33N R 27W</u>	<u>C04</u>
	T ___ R ___	___
	T ___ R ___	___
	T ___ R ___	___
2. Property Controlling in Section	S ___ T ___ R ___	___
	S ___ T ___ R ___	___
3. Miscellaneous Property in Sec.	S ___ T ___ R ___	___
	S ___ T ___ R ___	___

RECEIVED FOR RECORD
97 JAN 17 AM 8:45
PAGE # 450, BK 5
BARBARA MORRISON
REGISTER OF DEEDS
MENOMINEE, MI 49858
Register of Deeds Stamp & File Number

4. Lot No. _____, Recorded Plat _____
5. Private Claims _____

I, William Lenca, in a field survey on Dec. 06, 1996 do hereby state that under requirements of P.A. 74, Michigan P.A. of 1970, the corner points mentioned in lines 1 and 2 above were in conformance with regulations and rules therefore as required in the current manual of survey instructions of the United States Department of the Interior, Bureau of Land Management or by a decree of a Court of Law and/or that the corner points mentioned in lines 3, 4 and 5 above were in conformance with the rules of the Michigan Board of Land Surveyors or by a Decree of a Court of Law; established, re-established, monumented, recovered, found as expressed below:

NOTE: Not more than 2 corners, all in the same town and range, may be recorded on this certificate.

A	B	C	D	E	F	G	H	I	J	K	L	M
1												
2	6		5		4		3		2		1	
3												
4	7	●	8		9		10		11		12	
5												
6	18		17		16		15		14		13	
7												
8	19		20		21		22		23		24	
9												
10	30		29		28		27		26		25	
11												
12	31		32		33		34		35		36	
13												

A. Description of original monument and accessories and/or subsequent restoration:


- 1848: Original Survey by John Mullett - B.T.'s - Cedar, 24" - S06°E - 16 lks.; Cedar, 8" - N10°E - 08 lks. All original evidence for this corner has been destroyed by farming activities.
- 1981: CERTIFIED SURVEY NO. 223 by George B. Wilson, RLS No. 17607, shows this corner as it relates to other corners in Section 8, T33N-R27W. The survey states that this corner was "Established by John Jenkins, Surveyor" at an old fence corner. (Jenkins surveyed in this area in the early 1920's.) The corner monument is described in the legend as a 1/2" x 18" iron pin.

B. Description of corner evidence found and/or method applied in restoring or reestablishing corner:

We recovered a 1/2 inch diameter x 18 inch long iron rod with plastic identification cap marked RLS 17607 at an ancient fence corner - fences run West and North. The existing iron fits with dimensions shown in Certified Survey No. 223. The monumented and occupied position falls 133 feet South of a halfway split for the mile, however this corner has been used for many years by local surveyors, and is accepted as the best available evidence of the position of the original corner.

C. Description of monument for corner and accessories established to perpetuate locating the position of the corner:
Set 2" dia. Aluminum Pipe/3-1/4" dia. Alum. cap stamped for corner location:

7" dia. Maple	N27°E	16.68 feet	Scr. NBT
9" dia. White Ash	S87°E	49.00 feet	Scr. NBT
9" dia. Maple	S29°W	8.83 feet	Scr. NBT
10" dia. Maple	S70°W	20.83 feet	Scr. NBT
Metal Survey Sign Post	N78°W	1.3 feet	

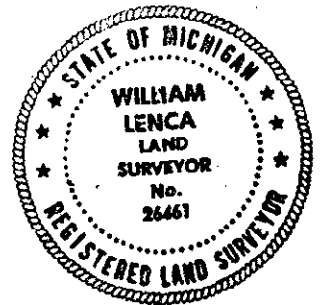

NOTE: All bearings are magnetic bearings. All distances are measured with steel tape. Distances to trees are to nail in side of tree.

Signed by William Lenca
Surveyor's Michigan License No. 26461

Date Dec. 19, 1996