

SURVEY & REMONUMENTATION

APR 11 1995

COMMISSION

LAND CORNER RECORDATION CERTIFICATE
Filing Requirement of Act 74, Mich. P.A. 1970

Approved by Menominee County
Land Survey Remonumentation
Peer Group Under Act 345 Of
P.A. Of 1990 On 12/9 19994

For corners in
MENOMINEE
(County)

Located In: Corner Code #

- 1. Public Land Survey T 33N R 27W C-12
T _____ R _____
T _____ R _____
T _____ R _____
- 2. Property Controlling S _____ T _____ R _____
in Section S _____ T _____ R _____
- 3. Miscellaneous S _____ T _____ R _____
Property in Sec. S _____ T _____ R _____

RECEIVED FOR RECORD
94 DEC 12 AM 8:59
PAGE # 114 BK 4
BARBARA MORRISON
REGISTER OF DEEDS
MENOMINEE MI 49858
ACTING CLERK
MEZ JAVIS RLS
Register of Deeds Stamp & File Number

- 4. Lot No. _____, Recorded Plat _____
- 5. Private Claims _____

William Lenca Jun 29 19 94

I, _____, in a field survey on _____, 19 _____, do hereby certify that under requirements of P.A. 74, Michigan P.A. of 1970, the corner points mentioned in lines 1 and 2 above were in conformance with regulations and rules therefore as required in the current manual of survey instructions of the United States Department of the Interior, Bureau of Land Management or by a decree of a Court of Law and/or that the corner points mentioned in lines 3, 4 and 5 above were in conformance with the rules of the Michigan Board of Land Surveyors or by a Decree of a Court of Law; established, re-established, monumented, re-monumented, recovered, found as expressed below:

NOTE: Not more than 4 corners, all in the same town and range, may be recorded on this certificate.


A	B	C	D	E	F	G	H	I	J	K	L	M
2	6	5	4	3	2	1						
3												
4	7	8	9	10	11	12						
5												
6	18	17	16	15	14	13						
7												
8	19	20	21	22	23	24						
9												
10	30	29	28	27	26	25						
11												
12	31	32	33	34	35	36						
13												

A. Description of original monument and accessories and/or subsequent restoration:

- 1848: Original Survey by John Mullett - B.T.'s - Spruce, 4" - N46°E - 13 lks; Spruce, 14" - N14°W - 05 lks. No original evidence found.
- 1896: A.L. Hillis made a survey of this area and used this corner. He describes it only as "stake" and gives no B.T.'s.
- 1974: L.C.R.C. No. 74 by George B. Wilson, RLS No. 17607 - states that he found a very old 3" square wood stake in good condition below water line. He states that from the condition of the stake, he believes it could be 75 years old. He set a 4" dia. concrete monument with 1/2" iron rod encased and the following B.T.'s - 4" Tam. - N35°E - 15.2'; 5" Tam. - N22°W - 18.0'; 5" Tam. - S05°E - 13.9'.

B. Description of corner evidence found and/or method applied in restoring or reestablishing corner:

We found a 4" diameter concrete monument and the 3 B.T.'s described in L.C.R.C. No. 74. This position has been accepted as the corner for almost 100 years. We therefore accepted the concrete monument as the best available evidence of the position of the original corner.

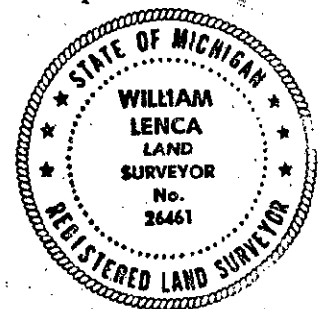

C. Description of monument for corner and accessories established to perpetuate locating the position of the corner:

Set 3-1/4" dia. Aluminum cap stamped for corner, on Existing 4" diameter concrete monument:

5" dia. Black Spruce	N36°E	17.22 feet	Scr. NBT
6" dia. Black Spruce	S01°W	14.82 feet	Scr. NBT
8" dia. Tamarack	S19°W	71.20 feet	Scr. NBT
5" dia. Black Spruce	N49°W	20.92 feet	Scr. NBT
7" dia. Tamarack	N17°W	74.66 feet	Scr. NBT
Survey Sign Post	S03°W	0.6 feet	

NOTE: All bearings are magnetic bearings. All distances are measured with steel tape. Distances to trees are to nail in side of tree.

Signed by William Lenca Date Nov. 18, 1994

Surveyor's Michigan License No. 26461

114