

**SURVEY & REMONUMENTATION**

**LAND CORNER RECORDATION CERTIFICATE**  
Filing Requirement of Act 74, Mich. P.A. 1970

Approved by Menominee County  
Land Survey Remonumentation  
Peer Group Under Act 345 Of  
P.A. Of 1990 On 12/9 1994  
MEL DAVIS RLS  
Acting Chairman

For corners in  
MENOMINEE  
(County)

APR 11 1995

COMMISSION

Located In:


Corner Code #

- |                                    |                           |       |
|------------------------------------|---------------------------|-------|
| 1. Public Land Survey              | T <u>33N</u> R <u>27W</u> | E-5   |
|                                    | T _____ R _____           | _____ |
|                                    | T _____ R _____           | _____ |
|                                    | T _____ R _____           | _____ |
| 2. Property Controlling in Section | S _____ T _____ R _____   | _____ |
|                                    | S _____ T _____ R _____   | _____ |
| 3. Miscellaneous Property in Sec.  | S _____ T _____ R _____   | _____ |
|                                    | S _____ T _____ R _____   | _____ |

RECEIVED FOR RECORD  
94 DEC 12 AM 8:56  
PAGE # 91 1824  
BARBARA MORTONSON  
REGISTER OF DEEDS  
MENOMINEE MI 49858  
Register of Deeds Stamp & File Number

4. Lot No. \_\_\_\_\_, Recorded Plat \_\_\_\_\_  
5. Private Claims \_\_\_\_\_

I, William Lenca, in a field survey on July 07, 19 94, do hereby certify that under requirements of P.A. 74, Michigan P.A. of 1970, the corner points mentioned in lines 1 and 2 above were in conformance with regulations and rules therefore as required in the current manual of survey instructions of the United States Department of the Interior, Bureau of Land Management or by a decree of a Court of Law and/or that the corner points mentioned in lines 3, 4 and 5 above were in conformance with the rules of the Michigan Board of Land Surveyors or by a Decree of a Court of Law; established, re-established, monumented, re-monumented, recovered, found as expressed below:

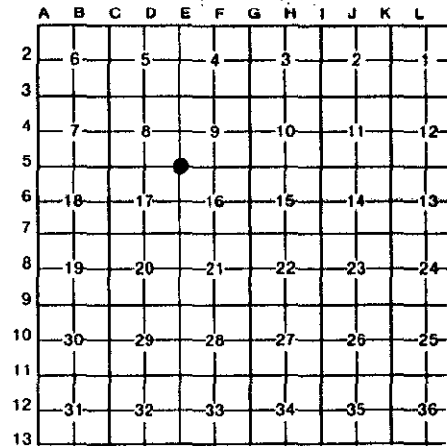

**NOTE: Not more than 4 corners, all in the same town and range, may be recorded on this certificate.**

**A. Description of original monument and accessories and/or subsequent restoration:**

- 1848: Original Survey by John Mullett - B.T.'s - Beech, 6", S40°W, 27 lks & Beech, 6", N23°E, 03 lks. All original evidence for this corner location has been destroyed by county road improvements.
- 1980: Certified Survey No. 183 recorded by George B. Wilson, RLS No. 17607 - No description of the corner monument is given.
- 1981: Certified Survey No. 223 recorded by George B. Wilson, RLS No. 17607 - No description of the corner monument is given.
- 1990: L.C.R.C. No. 892 by William Lenca, RLS No. 26461, states that a railroad spike was found set over an existing 4" dia. concrete monument - B.T.'s - Power Pole, S58°E, 69.00 feet/ Norway Pine, 7", S08°E, 53.93 feet/ Norway Pine, 5", S50°W, 71.30 feet/ 1/2" dia. iron pin/ident. cap (RLS 17607), North, 32.74 feet.

**B. Description of corner evidence found and/or method applied in restoring or reestablishing corner:**

A railroad spike was found in the centerline of an East - West asphalt surface county road. Upon digging, a 4 inch square concrete monument was found 18 inches below the road surface. This monument was apparently set by George B. Wilson, RLS No. 17607, since he monumented other corners in this section with a similar monument. The corner position falls in line with an old occupation line running North from this location, and fits with recorded distances shown in Certified Survey No. 183. The B.T.'s established in 1990, mentioned in part "A" still remain in good condition. This corner is accepted as the best available evidence of the position of the original corner.

**C. Description of monument for corner and accessories established to perpetuate locating the position of the corner:**  
Accepted the 4" square concrete monument - Set 3-1/4" dia. Alum. cap stamped for corner & set Monument Box:

7" dia. Norway Pine	S08°E	53.93 feet	Scr. NBT
8" dia. Norway Pine	S23°W	55.29 feet	Scr. NBT
5" dia. Norway Pine	S50°W	71.30 feet	Scr. NBT
1/2" dia. Iron Rod	North	32.74 feet	
Survey Sign Post	North	34.0 feet	

**NOTE: All bearings are magnetic bearings. All distances are measured with steel tape. Distances to trees are to nail in side of tree.**

Signed by William Lenca Date July 09, 1994  
Surveyor's Michigan License No. 26461