

SURVEY & REMONUMENTATION

APR 11 1995

LAND CORNER RECORDATION CERTIFICATE
Filing Requirement of Act 74, Mich. P.A. 1970

Approved by Menominee County
Land Survey Remonumentation
Peer Group Under Act 345 Of
P.A. Of 1990 On 12/19 199 94

For corners in COMMISSION
MENOMINEE
(County)


Located In:	Corner Code =#
1. Public Land Survey T <u>33N</u> R <u>27W</u>	<u>F-09</u>
T _____ R _____	_____
T _____ R _____	_____
T _____ R _____	_____
2. Property Controlling S _____ T _____ R _____	_____
in Section S _____ T _____ R _____	_____
3. Miscellaneous S _____ T _____ R _____	_____
Property in Sec. S _____ T _____ R _____	_____

ACTING Chairman
94 DEC 12 AM 9:00
RECEIVED FOR RECORD
PAGE # 121 BK 4
BARBARA MORRISON
REGISTER OF DEEDS
MENOMINEE MI 49858
Register of Deeds Stamp & File Number

4. Lot No. _____, Recorded Plat _____
5. Private Claims _____

William Lenca May 11 1994

I, _____, in a field survey on _____, 19 _____, do hereby certify that under requirements of P.A. 74, Michigan P.A. of 1970, the corner points mentioned in lines 1 and 2 above were in conformance with regulations and rules therefore as required in the current manual of survey instructions of the United States Department of the Interior, Bureau of Land Management or by a decree of a Court of Law and/or that the corner points mentioned in lines 3, 4 and 5 above were in conformance with the rules of the Michigan Board of Land Surveyors or by a Decree of a Court of Law; established, re-established, monumented, re-monumented, recovered, found as expressed below:

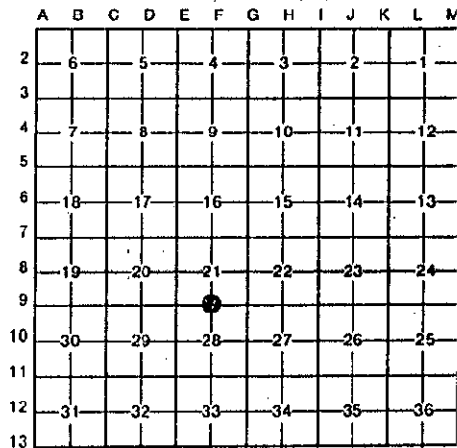


NOTE: Not more than 4 corners, all in the same town and range, may be recorded on this certificate.

A. Description of original monument and accessories and/or subsequent restoration:

- 1848: Original Survey by John Mullett - B.T.'s - Hemlock, 14" - N73°E - 30 lks; Hemlock, 14" - N35°W - 24 lks. All original evidence for this corner has been destroyed by County Road improvements.
1987: L.C.R.C. No. 750 by William Lenca, RLS No. 26461, states that a Deep-1 Magnet was set in the centerline of a East-West County Road and midway between the NE and NW Corners of Section 28. B.T.'s - Maple, 4" - N08°E - 38.56'; Birch, 6" - S45°E - 59.13'; Birch, 9" - S32°W - 45.78'.

B. Description of corner evidence found and/or method applied in restoring or reestablishing corner:

The deep-1 magnet mentioned in "A" had been destroyed by county road improvements, however all 3 B.T.'s were found in good condition. The corner position was replaced from the Bearing Trees described in L.C.R.C. No. 750, and is accepted as the best available evidence of the position of the original corner.

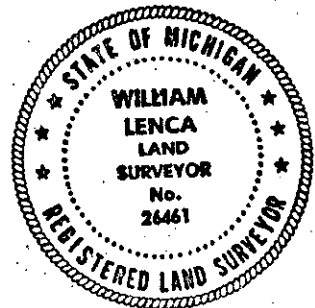

C. Description of monument for corner and accessories established to perpetuate locating the position of the corner:

Set 5/8" x 24" Iron Rod/3-1/4" dia. Alum. cap stamped for corner location in Monument Box:

4" dia. Maple - (Existing B.T.)	N08°E	38.56 feet	Scr. NBT
6" dia. White Birch - (Existing B.T.)	S45°E	59.13 feet	Scr. NBT
1-1/4" dia. Iron Pipe	S51°W	45.21 feet	
9" dia. White Birch Stump - (Existing B.T.)	S32°W	45.78 feet	Scr. NBT
5" dia. Maple	N55°W	74.06 feet	Scr. NBT
Survey Sign Post	N02°E	32.1 feet	

NOTE: All bearings are magnetic bearings. All distances are measured with steel tape. Distances to trees are to nail in side of tree.

Signed by William Lenca Date: Nov. 18, 1994
Surveyor's Michigan License No. 26461

121