

Mr. Davis BCS  
Chairman

LAND CORNER RECORDATION CERTIFICATE  
Filing Requirement of Act 74, Mich. P.A. 1970

For corners in  
MENOMINEE  
(County)

Located In:	Corner Code #
T33N R 27W	L5
T R	
T R	
T R	
S T R	
S T R	
S T R	
S T R	


- Public Land Survey
- Property Controlling in Section
- Miscellaneous Property in Sec.

RECEIVED FOR RECORD  
95 DEC 27 PM 3:28  
PAGE 1859 BK 1  
BANGS & WILSON  
REGISTERED PROFESSIONAL SURVEYORS  
REGISTERED OFFICE  
REGISTERED ADDRESS

Register of Deeds Stamp & File Number

4. Lot No. \_\_\_\_\_, Recorded Plat \_\_\_\_\_  
5. Private Claims \_\_\_\_\_

I, William Lenca, in a field survey on Apr 13, 1995 do hereby state that under requirements of P.A. 74, Michigan P.A. of 1970, the corner points mentioned in lines 1 and 2 above were in conformance with regulations and rules therefore as required in the current manual of survey instructions of the United States Department of the Interior, Bureau of Land Management or by a decree of a Court of Law and for that the corner points mentioned in lines 3, 4 and 5 above were in conformance with the rules of the Michigan Board of Land Surveyors or by a Decree of a Court of Law, established, re-established, monumented, recovered, found as expressed below:

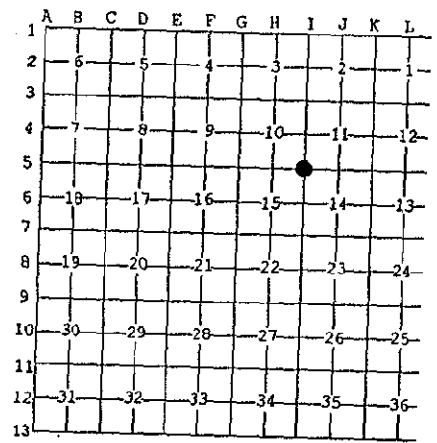

NOTE: Not more than 2 corners, all in the same town and range, may be recorded on this certificate.

A. Description of original monument and accessories and/or subsequent restoration:

- 1848: Original Survey by James H. Mullett - B.T.'s - Cedar, 12" - S13°E - 15 lks; Cedar, 12" - S27°W - 12 lks. All original evidence has been destroyed by U.S. Highway 41 construction.
- 1977: L.C.R.C. No. 165 by George B. Wilson, RLS No. 17607, states that a 2" dia. alum. pipe with cap marked "100 year flood - Menominee River" was set from 1877 Railroad map in which Section Corners were tied into the centerline of the track. TIES: centerline of U.S. 41 - West - 46.8 feet.

B. Description of corner evidence found and/or method applied in restoring or reestablishing corner:

In our 1995 Remonumentation Survey, we recovered a 2" diameter aluminum pipe with a 3-1/4 inch diameter aluminum cap marked "100 YEAR FLOOD - MENOMINEE RIVER". The corner falls 46.8 feet East of the centerline of U.S. Highway 41 and in line with the centerline of a county road running West. This corner has been used by local surveyors for 18 years, and is accepted as the best available evidence of the position of the original corner.



C. Description of monument for corner and accessories established to perpetuate locating the position of the corner:  
Accepted 2" dia. Alum. Pipe/3-1/4" dia. Alum. cap marked "100 YEAR FLOOD - MENOMINEE RIVER":

5/8" x 24" Iron Rod/2" dia. Alum. cap marked "WITNESS MARKER"	N18°E	35.58 feet	
11" dia. Elm	N78°E	102.75 feet	Scr. NBT
4" dia. Elm	S51°E	92.68 feet	Scr. NBT
12" dia. Elm	S59°W	131.76 feet	Scr. NBT
Metal Survey Sign Post	N18°E	36.2 feet	

NOTE: All bearings are magnetic bearings. All distances are measured with a steel tape. Distances to trees are to nail in side of tree.

Signed by William Lenca Date Nov. 24, 1995  
Surveyor's Michigan License No. 26461