

SURVEY & REMONUMENTATION

Approved by Menominee County
Land Survey Remonumentation
Peer Group Under Act 345 Of

P.A. Of 1990 On 12/9 199 94

LAND CORNER RECORDATION CERTIFICATE Filing Requirement of Act 74, Mich. P.A. 1970

For corners in APR 1 1 1995
MENOMINEE
(County)

COMMISSION

Located In: _____ Corner Code -# _____

McDAVIS BLS
ACTING Chairman
PAGE # 129 B.R. # 4
RECEIVED FOR RECORD
94 DEC 12 AM 9:00
BARBARA MORRISON
REGISTER OF DEEDS
MENOMINEE MI 49853


Register of Deeds Stamp & File Number

- | | | | | |
|------------------------------------|---|-------------|------------|-------------|
| 1. Public Land Survey | T | <u>33NR</u> | <u>27W</u> | <u>1-09</u> |
| | T | _____ | _____ | _____ |
| | T | _____ | _____ | _____ |
| | T | _____ | _____ | _____ |
| 2. Property Controlling in Section | S | _____ | T | _____ |
| | S | _____ | T | _____ |
| 3. Miscellaneous Property in Sec. | S | _____ | T | _____ |
| | S | _____ | T | _____ |

4. Lot No. _____, Recorded Plat _____
5. Private Claims _____

William Lenca Mar. 11 1994

I, _____, in a field survey on _____, 19____, do hereby certify that under requirements of P.A. 74, Michigan P.A. of 1970, the corner points mentioned in lines 1 and 2 above were in conformance with regulations and rules therefore as required in the current manual of survey instructions of the United States Department of the Interior, Bureau of Land Management or by a decree of a Court of Law and/or that the corner points mentioned in lines 3, 4 and 5 above were in conformance with the rules of the Michigan Board of Land Surveyors or by a Decree of a Court of Law; established, re-established, monumented, re-monumented, recovered, found as expressed below:

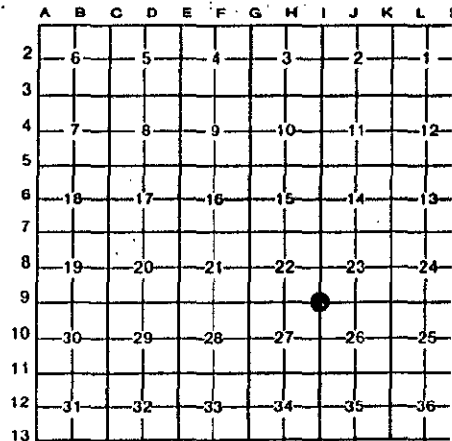

NOTE: Not more than 4 corners, all in the same town and range, may be recorded on this certificate.

A. Description of original monument and accessories and/or subsequent restoration:

- 1848: Original Survey by John Mullett - B.T.'s - Elm, 10" - N42°E - 48 lks; Elm, 6" - N41°W - 35 lks. All original evidence for this corner has been destroyed by Highway Construction.
- 1982: L.C.R.C. No. 543 by William Lenca, RLS No. 26461, states that a P.K. Nail was set in U.S. Highway 41 by extending line and doubling distance between the E1/4 corner and teh S1/16 Corner on the East Line of Section 22. This places the corner 128 feet East of the Center of the C & NW Railroad, which fits with the distance shown on an 1877 map of this Railroad. TIES: PP - N70°W - 67.38'; Conc. Ped. for Tele Box - S64°W - 49.06'; C/L U.S. Highway 41 - West - 2.5'.
- 1991: L.C.R.C. No. 923 by Brian Taavola, RLS No. 21583, states that a P.K. Nail was found 2.5 feet East of the c/l of US Highway 41 - Set 1/2" Copper clad steel rod/cap "MDOT 21583" in Monument Box - TIES - N66W - 67.44' Power Pole; S47E - 92.81' - 18" Elm; S63W - 63.05' - NE Corner Tele. Box; S86W - 125.56' - C/L of Co. Rd. @ C/L of 1st rail (rr Track)

B. Description of corner evidence found and/or method applied in restoring or reestablishing corner:

We found the 1/2" dia. copper clad steel rod with yellow plastic cap embossed "MDOT 21583" set inside of a monument box as described in L.C.R.C. No. 923. We also recovered the ties described in L.C.R.C. No. 543 and L.C.R.C. No. 923. These ties check with the location of the existing monument. This corner has been used as control for several surveys over the past 12 years, and is accepted as the best available evidence of the position of the original corner.



C. Description of monument for corner and accessories established to perpetuate locating the position of the corner:

Accepted 1/2" dia. copper clad steel rod/cap marked "MDOT 21583" set in Monument Box:

8" dia. White Ash	N65°E	90.30 feet	Scr. NBT
18" dia. Elm	S46°E	92.97 feet	Scr. NBT
5/8" x 24" Iron Rod/2" Alum. cap marked "WITNESS MARKER"	S56°W	64.15 feet	
5/8" x 24" Iron Rod/2" Alum. cap marked "WITNESS MARKER"	N49°W	54.66 feet	
Survey Sign Post	N57°W	71.3 feet	

NOTE: All bearings are magnetic bearings. All distances are measured with steel tape. Distances to trees are to nail in side of tree.

Signed by William Lenca Date Nov. 21, 1994
Surveyor's Michigan License No. 26461