

SURVEY & REMONUMENTATION

APR 1 1 1995

COMMISSION

Approved by Menominee County
Land Survey Remonumentation
Peer Group Under Act 345 Of
P.A. Of 1990 On 12/9 199 94

LAND CORNER RECORDATION CERTIFICATE
Filing Requirement of Act 74, Mich. P.A. 1970

For corners in
MENOMINEE
(County)

Located In: Corner Code #

- | | | | | | |
|------------------------------------|---|-------------|---|-------------|-------------|
| 1. Public Land Survey | T | <u>33</u> N | R | <u>27</u> W | <u>I-10</u> |
| | T | _____ | R | _____ | _____ |
| | T | _____ | R | _____ | _____ |
| | T | _____ | R | _____ | _____ |
| 2. Property Controlling in Section | S | _____ | T | _____ | R |
| | S | _____ | T | _____ | R |
| 3. Miscellaneous Property in Sec. | S | _____ | T | _____ | R |
| | S | _____ | T | _____ | R |

ACTING Chairman
Mez Dwin RLS
PAGE # 130 & K. 4
94 DEC 12 AM 9:00
RECEIVED FOR RECORD
BARBARA MORRISON
REGISTER OF DEEDS
MENOMINEE, MI 49858
Register of Deeds Stamp & File Number

4. Lot No. _____, Recorded Plat _____
5. Private Claims _____

William Lenca Mar. 11 94

I, _____, in a field survey on _____, 19 _____, do hereby certify that under requirements of P.A. 74, Michigan P.A. of 1970, the corner points mentioned in lines 1 and 2 above were in conformance with regulations and rules therefore as required in the current manual of survey instructions of the United States Department of the Interior, Bureau of Land Management or by a decree of a Court of Law and/or that the corner points mentioned in lines 3, 4 and 5 above were in conformance with the rules of the Michigan Board of Land Surveyors or by a Decree of a Court of Law; established, re-established, monumented, re-monumented, recovered, found as expressed below:

NOTE: Not more than 4 corners, all in the same town and range, may be recorded on this certificate.


A	B	C	D	E	F	G	H	I	J	K	L
2	6	5	4	3	2	1					
3											
4	7	8	9	10	11	12					
5											
6	18	17	16	15	14	13					
7											
8	19	20	21	22	23	24					
9											
10	30	29	28	27	26	25					
11											
12	31	32	33	34	35	36					
13											

A. Description of original monument and accessories and/or subsequent restoration:

- 1848: Original Survey by John Mullett - B.T.'s - Cedar, 6" - N20°E - 48 lks; Cedar, 8" - S72°W - 13 lks. All original evidence for this corner has been destroyed by Highway Construction.
1987: L.C.R.C. No. 751 by William Lenca, RLS No. 26461, states that a 5/8" x 24" Iron Rod/Ident. cap was set on line and midway between the NE Corner and the SE Corner of Section 27, T33N-R27W. New B.T.'s - PP #286 - N21°W - 133.04'; Telegraph Pole - S60°W - 85.83'; PP #285 - S18°W - 144.48'; C/L US 41 - East - 25.6'; C/L RR - West - 100.6'.

B. Description of corner evidence found and/or method applied in restoring or reestablishing corner:

We recovered the 5/8" x 24" Iron Rod/Ident. cap and corner ties as described in L.C.R.C. No. 751. We found no evidence of old fences in the area. We therefore accepted the corner, as placed by single proportion, as a careful and faithful re-establishment of the position of the original corner.

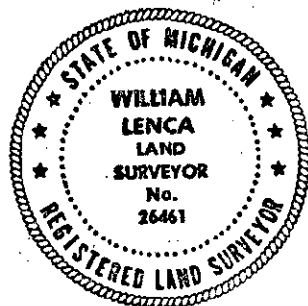

C. Description of monument for corner and accessories established to perpetuate locating the position of the corner:

Set 2-1/2" dia. Aluminum Pipe 30" long/3-1/4" dia. Aluminum cap stamped for corner:

- | | | | |
|-------------------|-------|-------------|----------|
| 5" dia. White Ash | N43°E | 170.24 feet | Scr. NBT |
| 5" dia. White Ash | S62°E | 150.92 feet | Scr. NBT |
| 7" dia. White Ash | S46°W | 170.70 feet | Scr. NBT |
| 7" dia. White Ash | N52°W | 169.22 feet | Scr. NBT |
| Survey Sign Post | N85°W | 50.0 feet | |

NOTE: All bearings are magnetic bearings. All distances are measured with steel tape. Distances to trees are to nail in side of tree.

Signed by William Lenca Date Nov. 21, 1994
Surveyor's Michigan License No. 26461