SURVEY & REMONUMENTATION

APR 1 1 1995

COMMISSION

Approved by Menominee County Land Survey Remonumentation Peer Group Under Act 345 Of P.A. Of 1990 On 12/9, 1994

Mike Davis RLS

Chairman

ACTING

RECEIVED FOR RECORD

94 DEC 12 AM 9:00

PAGE #133 BK. 4

BARBARA MORRISON REGISTER OF DEEDS MENOMINEE, MI 49858

Register of Deeds Stamp & File Number

LAND CORNER RECORDATION CERTIFICATE

Filing Requirement of Act 74, Mich. P.A. 1970

For corners in MENOMINEE (County) located in:

Corner Code ##

1. Public Land Survey — T 33N R 27W — J-09
   T ___ R ___
   T ___ R ___
   T ___ R ___
2. Property Controlling — S ___ T ___ R ___
   in Section — S ___ T ___ R ___
3. Miscellaneous — S ___ T ___ R ___
   Property in Sec. — S ___ T ___ R ___
4. Lot No. ___, Recorded Plat ___
5. Private Claims ___

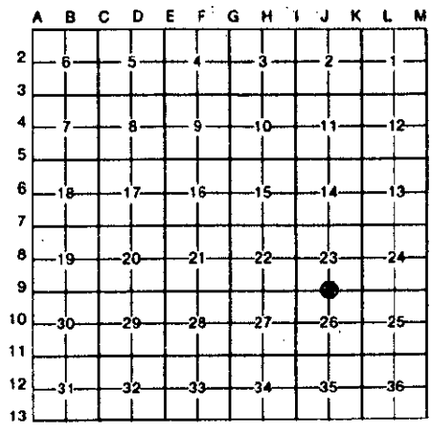

I, William Lenca, in a field survey on Mar. 31, 19 94, do hereby certify that under requirements of P.A. 74, Michigan P.A. of 1970, the corner points mentioned in lines 1 and 2 above were in conformance with regulations and rules therefore as required in the current manual of survey instructions of the United States Department of the Interior, Bureau of Land Management or by a decree of a Court of Law and/or that the corner points mentioned in lines 3, 4 and 5 above were in conformance with the rules of the Michigan Board of Land Surveyors or by a Decree of a Court of Law; established, re-established, monumented, re-monumented, recovered, found as expressed below:

NOTE: Not more than 4 corners, all in the same town and range, may be recorded on this certificate.

A. Description of original monument and accessories and/or subsequent restoration:

1848: Original Survey by John Mullett - B.T.'s - Black Ash, 8" - S81°E - 12 lks; Black Ash, 6" - S23°W - 07 lks. All original evidence for this corner has been destroyed by county road improvements.

B. Description of corner evidence found and/or method applied in restoring or reestablishing corner:

We recovered a "Deep - 1" magnet in the centerline of a North - South County Road and in line with the extension West of a very old fence line East of this location. The distance from the corner position East to the 1/16 corner, as fenced, is 1373 feet. The distance from the corner position East to the Section Corner is 2749 feet. The corner position fits well with existing lines of occupation, and is accepted as the best available evidence of the position of the original corner.

C. Description of monument for corner and accessories established to perpetuate locating the position of the corner:

Set 5/8" x 24" Iron Rod/3-1/4" dia. Aluminum cap stamped for corner location:

8" dia. White Ash	N60°E	55.94 feet	Scr. NBT
9" dia. White Ash	S58°E	31.41 feet	Scr. NBT
7" dia. White Ash	S60°W	60.56 feet	Scr. NBT
8" dia. White Ash	N44°W	78.22 feet	Scr. NBT
Survey Sign Post	S86°W	28.7 feet	

NOTE: All bearings are magnetic bearings. All distances are measured with steel tape. Distances to trees are to nail in side of tree.

Signed by William Lenca Date Nov. 22, 1994

Surveyor's Michigan License No. 26461

FORM APPROVED BY MICHIGAN STATE BOARD OF LAND SURVEYORS, JAN. 28, 1971
REVISED MAY 14, 1975
REVISED JAN., 1983