SURVEY & REMONUMENTATION

APR 1 1 1995

COMMISSION

Approved by Menominee County Land Survey Remonumentation Peer Group Under Act 345 Of P.A. Of 1990 On 12/9, 1994

Chairman

LAND CORNER RECORDATION CERTIFICATE

Filing Requirement of Act 74, Mich. P.A. 1970

For corners in MENOMINEE (County)

	Located In:	Corner Code ##
1. Public Land Survey	T 33N R 27W	M-10
	T ___ R ___	
	T ___ R ___	
	T ___ R ___	
2. Property Controlling	S ___ T ___ R ___	
in Section	S ___ T ___ R ___	
3. Miscellaneous	S ___ T ___ R ___	
Property in Sec.	S ___ T ___ R ___	

RECEIVED FOR RECORD
94 DEC 12 AM 9:01
BARBARA MORRISON
REGISTER OF DEEDS
MENOMINEE, MI 49858
PAGE # 143 BK. 4

Register of Deeds Stamp & File Number

4. Lot No. _____, Recorded Plat _____
5. Private Claims _____

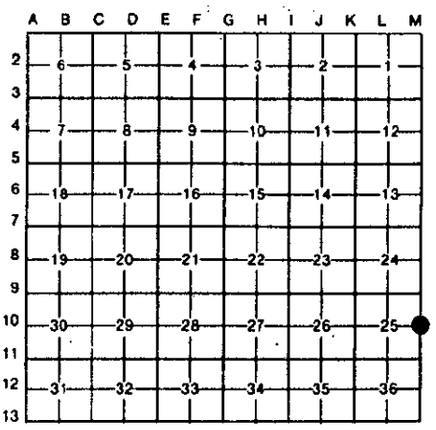

I, William Lenca, in a field survey on Oct. 04, 19 94, do hereby certify that under requirements of P.A. 74, Michigan P.A. of 1970, the corner points mentioned in lines 1 and 2 above were in conformance with regulations and rules therefore as required in the current manual of survey instructions of the United States Department of the Interior, Bureau of Land Management or by a decree of a Court of Law and/or that the corner points mentioned in lines 3, 4 and 5 above were in conformance with the rules of the Michigan Board of Land Surveyors or by a Decree of a Court of Law; established, re-established, monumented, re-monumented, recovered, found as expressed below:

NOTE: Not more than 4 corners, all in the same town and range, may be recorded on this certificate.

A. Description of original monument and accessories and/or subsequent restoration:

1847 - Original Survey (Township Exterior) by James H. Mullett - B.T.'s - Tamarack, 14" - N34°W - 19 lks; Spruce, 8" - S15°W - 44 lks. All original evidence for this corner has been destroyed by County Road improvements.

B. Description of corner evidence found and/or method applied in restoring or reestablishing corner:

We found a 1/2 inch diameter iron rod 3.5 feet East of the centerline of a North - South County Road. The distance 1/4 mile north to a well defined, long standing occupation line is 1350.9 feet splitting the 1/2 mile distance of 2701.8 feet. This corner has been used by local surveyors and is accepted as the best available evidence of the position of the original corner.

C. Description of monument for corner and accessories established to perpetuate locating the position of the corner:

Set 5/8" x 24" Iron Rod/3-1/4" dia. Aluminum cap stamped for corner location in Monument Box:

10" dia. Maple	N62°E	53.82 feet	Scr. NBT
9" dia. Tamarack	S42°E	58.18 feet	Scr. NBT
6" dia. Tamarack	S82°W	41.38 feet	Scr. NBT
10" dia. Tamarack	N30°W	86.00 feet	Scr. NBT
Survey Sign Post	West	36.3 feet	

NOTE: All bearings are magnetic bearings. All distances are measured with steel tape. Distances to trees are to nail in side of tree.

Signed by William Lenca Date Dec. 05, 1994

Surveyor's Michigan License No. 26461

FORM APPROVED BY MICHIGAN STATE BOARD OF LAND SURVEYORS, JAN. 28, 1971
REVISED MAY 14, 1975
REVISED JAN., 1983