

LAND CORNER RECORDATION CERTIFICATE  
Filing Requirement of Act 74, Mich. P.A. 1970

For corners in

Menominee  
(County)

Located In:

Corner Code: #1

- 1. Public Land Survey T 34N R 25W C-2
- T R
- T R
- T R
- 2. Property Controlling S T R
- in Section S T R
- 3. Miscellaneous S T R
- Property in Sec. S T R

Also 21, 20, 18

Register of Deeds Stamp & File Number

- 4. Lot No. \_\_\_\_\_, Recorded Plat \_\_\_\_\_
- 5. Private Claims \_\_\_\_\_

|    | A  | B  | C  | D  | E  | F  | G | H | I | J | K | L | M |
|----|----|----|----|----|----|----|---|---|---|---|---|---|---|
| 2  | 6  | 5  | 4  | 3  | 2  | 1  |   |   |   |   |   |   |   |
| 3  |    |    |    |    |    |    |   |   |   |   |   |   |   |
| 4  | 7  | 8  | 9  | 10 | 11 | 12 |   |   |   |   |   |   |   |
| 5  |    |    |    |    |    |    |   |   |   |   |   |   |   |
| 6  | 18 | 17 | 16 | 15 | 14 | 13 |   |   |   |   |   |   |   |
| 7  |    |    |    |    |    |    |   |   |   |   |   |   |   |
| 8  | 19 | 20 | 21 | 22 | 23 | 24 |   |   |   |   |   |   |   |
| 9  |    |    |    |    |    |    |   |   |   |   |   |   |   |
| 10 | 30 | 29 | 28 | 27 | 26 | 25 |   |   |   |   |   |   |   |
| 11 |    |    |    |    |    |    |   |   |   |   |   |   |   |
| 12 | 31 | 32 | 33 | 34 | 35 | 36 |   |   |   |   |   |   |   |
| 13 |    |    |    |    |    |    |   |   |   |   |   |   |   |

I, Paul R. Bressette, in a field survey on May 14, 19 92, do hereby certify that under requirements of P.A. 74, Michigan P.A. of 1970, the corner points mentioned in lines 1 and 2 above were in conformance with regulations and rules therefore as required in the current manual of survey instructions of the United States Department of the Interior, Bureau of Land Management or by a decree of a Court of Law and/or that the corner points mentioned in lines 3, 4 and 5 above were in conformance with the rules of the Michigan Board of Land Surveyors or by a Decree of a Court of Law; established, re-established, monumented, re-monumented, recovered, found as expressed below:

NOTE: Not more than 4 corners, all in the same town and range, may be recorded on this certificate.

A. Description of original monument and accessories and/or subsequent restoration:


C-2. Quarter Corner common to Sections 5 and 6. Restored in 1982 by Dave Babbitt, RLS. Set 1" iron pipe with 4" aluminum cap witnessed by: 6" R. Maple S 16° W 29.6'; 10" W. Birch N 53° W 14.3'; 16" R. Maple S 54° E 28.0'; 5" R. Maple N 63° E 46.2'. In 1983 two new witnesses were established to replace two that were destroyed: a 15" R. Maple S 81° E 37.9' and a 9" W. Birch S 41° W 21.8'. In 1987 two more witnesses were established to replace two that had been destroyed: a 4" W. Birch S 28° W 6.4' and a 8" R. Maple N 39° W 43.7'.

B. Description of corner evidence found and/or method applied in restoring or reestablishing corner:

C-2. Found 1" iron pipe with cap broken off 3" below grade and 3 witnesses, a 8" R. Maple NW still living, a 10" W. Birch NW dead, and a 4" W. Birch SW cut down. Left the iron pipe in place and marked 3 new witnesses.

C. Description of monument for corner and accessories established to perpetuate locating the position of the corner:

C-2. 1" iron pipe 3" below grade  
4" Red Maple S 47° E 27.1'  
6" White Birch S 06° W 49.7'  
8" White Birch S 58° W 23.45'  
\*8" Red Maple N 33° W 43.7'  
\*old NBT (1987)

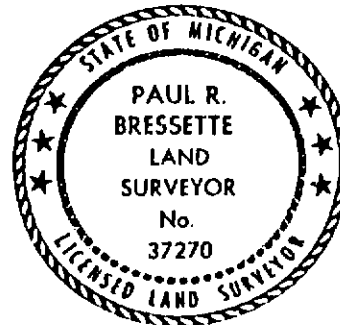

Signed by Paul R. Bressette

Date 6-17-92

Surveyor's Michigan License No. 37270