

# SURVEY & REMONUMENTATION


OCT 26 1993

Approved by Menominee County  
Land Survey Remonumentation  
Peer Group Under Act 345 Of  
P.A. Of 1990 On OCT 19 1993  
W. J. L. RLS  
Chairman (ACTING)

## LAND CORNER RECORDATION CERTIFICATE Filing Requirement of Act 74, Mich. P.A. 1970

COMMISSION  
For corners in

<u>MENOMINEE</u> (County)	Located In:	Corner Code -#
1. Public Land Survey	T 34N R 25W	C-1
	T _____ R _____	_____
	T _____ R _____	_____
	T _____ R _____	_____
2. Property Controlling in Section	S _____ T _____ R _____	_____
	S _____ T _____ R _____	_____
3. Miscellaneous Property in Sec.	S _____ T _____ R _____	_____
	S _____ T _____ R _____	_____
4. Lot No. _____, Recorded Plat _____		
5. Private Claims _____		

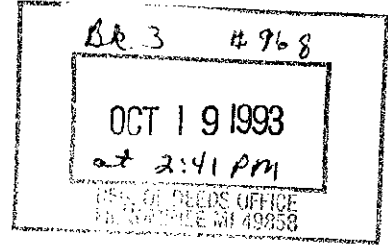

Register of Deeds Stamp & File Number

	A	B	C	D	E	F	G	H	I	J	K	L	M
2	6		5		4		3		2		1		
3													
4	7		8		9		10		11		12		
5													
6	18		17		16		15		14		13		
7													
8	19		20		21		22		23		24		
9													
10	30		29		28		27		26		25		
11													
12	31		32		33		34		35		36		
13													

I, William Lenca, in a field survey on August, 19 93, do hereby certify that under requirements of P.A. 74, Michigan P.A. of 1970, the corner points mentioned in lines 1 and 2 above were in conformance with regulations and rules therefore as required in the current manual of survey instructions of the United States Department of the Interior, Bureau of Land Management or by a decree of a Court of Law and/or that the corner points mentioned in lines 3, 4 and 5 above were in conformance with the rules of the Michigan Board of Land Surveyors or by a Decree of a Court of Law; established, re-established, monumented, re-monumented, recovered, found as expressed below:

**NOTE: Not more than 4 corners, all in the same town and range, may be recorded on this certificate.**

A. Description of original monument and accessories and/or subsequent restoration:

- ORIGINAL B.T.'s:  
Cedar, 6", S17°E, 13 lks  
B. Ash, 6", S38°W, 29 lks

Original Survey by James H. Mullett in 1848. This corner was re-established by single proportionate measurement by Frank J. Bray (DNR Surveyor) in 1970.

B. Description of corner evidence found and/or method applied in restoring or reestablishing corner:

In 1970, Frank J. Bray set this corner on line and single proportionate measurement between the Section Corner 1 mile East and the 1/4 Corner 1/2 Mile West. He established 2 Witness Trees - 10" Cedar, N15°E, 9.1' and 14" Cedar, S43°E, 19.5 feet. He also states that he set a 1" iron pipe with 4" aluminum cap. Evidently, the monument had been removed, but we found both witness trees, the 14" Cedar was in place, but the 10" Cedar had fallen over. We were able to place the fallen witness tree upright and replaced the corner from Bray's witnesses. This position is accepted as a careful and faithful re-establishment of the position of the original corner.

C. Description of monument for corner and accessories established to perpetuate locating the position of the corner:

- Set 2 1/2" x 30" Cone Monument/3 1/4" dia. Alum. cap stamed for corner:
- |                   |       |                      |
|-------------------|-------|----------------------|
| 10" dia. Cedar    | N15°E | 9.1 feet - Old B.T.  |
| 14" dia. Cedar    | S43°E | 19.5 feet - Old B.T. |
| 8" dia. White Ash | N43°E | 23.87 feet           |
| 9" dia. White Ash | S35°W | 14.63 feet           |
| 8" dia. Maple     | N39°W | 77.23 feet           |
| Carsonite Marker  | N30°W | 2.4 feet             |



NOTE: All bearings are magnetic bearings; all distances are measured with steel tape; all distances to trees are measured to nails in center of tree.

Signed by William Lenca Date Sept. 30, 1993  
Surveyor's Michigan License No. 26461