

LAND CORNER RECORDATION CERTIFICATE
Filing Requirement of Act 74, Mich. P.A. 1970

For corners in
T Menominee

Located In: Corner Code: //

1. Public Land Survey	T 34N	R 28W	
	T	R	
	T	R	
	T	R	
2. Property Controlling in Section	S 7	T R	9
	S	T R	12
3. Miscellaneous Property in Sec.	S	T R	13
	S	T R	

Register of Deeds Stamp & File Number

4. Lot No. _____, Recorded Plat _____
 5. Private Claims _____

I, Keith Sackett, in a field survey on August 5, 1991, do hereby certify that under requirements of P.A. 74, Michigan P.A. of 1970, the corner points mentioned in lines 1 and 2 above were in conformance with regulations and rules therefore as required in the current manual of survey instructions of the United States Department of the Interior, Bureau of Land Management or by a decree of a Court of Law and/or that the corner points mentioned in lines 3, 4 and 5 above were in conformance with the rules of the Michigan Board of Land Surveyors or by a Decree of a Court of Law; established, re-established, monumented, re-monumented, recovered, found as expressed below:

NOTE: Not more than 4 corners, all in the same town and range, may be recorded on this certificate.

	A	B	C	D	E	F	G	H	I	J	K	L	M
2	6		5		4		3		2		1		
3													
4	7		8		9		10		11		12		
5													
6	18		17		16		15		14		13		
7													
8	19		20		21		22		23		24		
9													
10	30		29		28		27		26		25		
11													
12	31		32		33		34		35		36		
13													

A. Description of original monument and accessories and/or subsequent restoration:


9	12	13
Center east one-sixteenth corner of Section 7. Not set in original survey nor subsequently, apparently.	Meander corner on N-S quarterline of Section 7. Not set in original survey nor subsequently, apparently.	Meander corner on east one-sixteenth line of Section 7. Not set in original survey nor subsequently, apparently.

B. Description of corner evidence found and/or method applied in restoring or reestablishing corner:

9	12	13
Set midway and on line.	Set on N-S quarterline on left bank of Menominee River.	Set on east one-sixteenth line on left bank of Menominee River.

C. Description of monument for corner and accessories established to perpetuate locating the position of the corner:

9	12	13
Set 1" I.D. x 32" iron pipe with 4" aluminum cap. 7" v. birch N35E 5.5', BT 7" v. pine S61E 28.8', BT 7" v. pine S22W 50.7', BT 14" red maple N46W 25.9', BT	Set 1" I.D. x 32" iron pipe with 4" aluminum cap. 12" silver maple N41E 17.4', BT silver maple S44E 19.4', BT 10" v. ash N39W 9.4', BT Squared 9" white oak north 1.6'	Set 1" I.D. x 32" iron pipe with 4" aluminum cap. 8" white ash N13E 48.6', BT 9" black ash S36E 6.55', BT 7" basswood S65W 22.85', BT 7" black ash N47W 18.8', BT

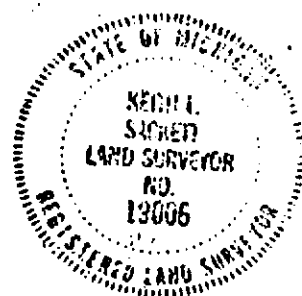

Signed by Keith Sackett Date September 5, 1991
 Surveyor's Michigan License No. 19006