

RECORDED  
APR 06 1998

Approved by Menominee County  
Land Survey Remonumentation  
Peer Group Under Act 345 Of  
P.A. Of 1990 On 12/30, 1998  
McL Davis RLS  
Chairman

SECTION

LAND CORNER RECORDATION CERTIFICATE  
Filing Requirement of Act 74, Mich. P.A. 1970

For corners in

<u>MENOMINEE</u> (County)	Located in:	Corner Code #
1. Public Land Survey	T <u>5</u> N R <u>28</u> W	<u>I-13</u>
	T___ R___	_____
	T___ R___	_____
	T___ R___	_____
2. Property Controlling in Section	S___ T___ R___	_____
	S___ T___ R___	_____
3. Miscellaneous Property in Sec.	S___ T___ R___	_____
	S___ T___ R___	_____

RECEIVED FOR RECORD  
99 JAN -6 AM 8:51  
PAGE # 700 BK 5  
BARBARA MORRISON  
REGISTER OF DEEDS  
MENOMINEE, MI 49859

Register of Deeds Stamp & File Number

4. Lot No. \_\_\_\_\_, Recorded Plat \_\_\_\_\_  
5. Private Claims \_\_\_\_\_

(SAME AS CORNER I-01, T34N - R28W.)

I, William Lenca, in a field survey on Nov. 20, 1998 do hereby state that under requirements of P.A. 74, Michigan P.A. of 1970, the corner points mentioned in lines 1 and 2 above were in conformance with regulations and rules therefore as required in the current manual of survey instructions of the United States Department of the Interior, Bureau of Land Management or by a decree of a Court of Law and /or that the corner points mentioned in lines 3, 4 and 5 above were in conformance with the rules of the Michigan Board of Land Surveyors or by a Decree of a Court of Law; established, re-established, monumented, recovered, found as expressed below:

A	B	C	D	E	F	G	H	I	J	K	L	M
1												
2	6		5		4		3		2		1	
3												
4	7		8		9		10		11		12	
5												
6	18		17		16		15		14		13	
7												
8	19		20		21		22		23		24	
9												
10	30		29		28		27		26		25	
11												
12	31		32		33		34		35		36	
13												

NOTE: Not more than 2 corners, all in the same town and range, may be recorded on this certificate.

A. Description of original monument and accessories and/or subsequent restoration:

- 1848: Original Survey - Township Boundary - by H. Brevoort, Jr. - B.T.'s - Lynn, 18" - N37°W - 18 lks.; Hemlock, 14" - N73°E - 20 lks. All original evidence for this corner has been destroyed by county road improvements.
- 1852: Original Survey - Sectional Subdivision - by Francis Coleman - B.T.'s - Hemlock, 8" - S55°E - 49 lks.; Hemlock, 18" - S35°W - 22 lks. All original evidence for this corner has been destroyed by county road improvements.
- 1985: Plat of Survey by William Lenca, RLS 26461, shows a tie to this corner.


B. Description of corner evidence found and/or method applied in restoring or reestablishing corner:

We found a 1/2" x 24" Iron from information contained in the 1985 Plat of Survey mentioned in part "A". the corner falls in line with the centerline of a county road to the North and with ancient fences East and South. This location matches well with measurements to corners 2 miles to the West and 1 mile North, and is accepted as the best available evidence of the position of the original corner.

C. Description of monument for corner and accessories established to perpetuate locating the position of the corner:

Set 2" dia. Aluminum Pipe 30" long/3-1/4" dia. Alum. cap stamped for corner location:

5/8" x 24" Iron Rod/2" dia. Alum. cap marked "WITNESS MARKER"	N36°E	71.62 feet	1' E. of Power Pole
20" dia. Maple	S69°E	52.77 feet	"X" in upper & lower
6" dia. Maple	S04°E	27.86 feet	"X" in upper & lower
20" dia. Spruce	S47°W	13.43 feet	"X" in upper & lower
Metal Survey Sign Post	South	0.9 feet	

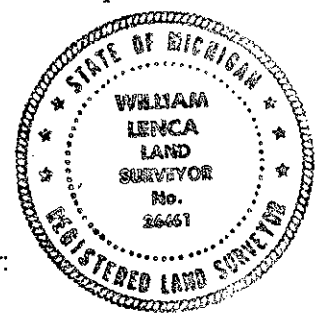

NOTE: All bearings are magnetic bearings. All distances are measured with steel tape. Distances to trees are to nail in side of tree.

Signed by William Lenca Date Dec. 22, 1998  
Surveyor's Michigan License No. 26461