

LAND CORNER RECORDATION CERTIFICATE  
Filing Requirement of Act 74, Mich. P.A. 1970

For corners in

Menominee <small>(County)</small>	Located In:	Corner Code //
1. Public Land Survey	T R	
	T R	
	T R	
2. Property Controlling in Section	S 2 T 34N. R 29W.	11,12,15
3. Miscellaneous Property in Sec.	S T R	
	S T R	

Register of Deeds Stamp & File Number

- 4. Lot No. \_\_\_\_\_, Recorded Plat \_\_\_\_\_
- 5. Private Claims \_\_\_\_\_

A	B	C	D	E	F	G	H	I	J	K	L	M
2	6	5	4	3	2							
3												
4	7	8	9	10	11	12						
5												
6	18	17	16	15	14	13						
7												
8	19	20	21	22	23	24						
9												
10	30	29	28	27	26	25						
11												
12	31	32	33	34	35	36						
13												

I, Paul Bressette, in a field survey on May 25, 19 94, do hereby certify that under requirements of P.A. 74, Michigan P.A. of 1970, the corner points mentioned in lines 1 and 2 above were in conformance with regulations and rules therefore as required in the current manual of survey instructions of the United States Department of the Interior, Bureau of Land Management or by a decree of a Court of Law and/or that the corner points mentioned in lines 3, 4 and 5 above were in conformance with the rules of the Michigan Board of Land Surveyors or by a Decree of a Court of Law; established, re-established, monumented, re-monumented, recovered, found as expressed below:

**NOTE: Not more than 4 corners, all in the same town and range, may be recorded on this certificate.**

A. Description of original monument and accessories and/or subsequent restoration:


- 11 Southwest one-sixteenth corner of Section 2. Found 1" iron pipe 29.95 feet northerly of monumented position.
- 12 South one-sixteenth corner of Section 2. Not set in original survey. No evidence of subsequent establishment.
- 15 West one-sixteenth corner common to Sections 2 and 11. Found 1" iron pipe east 16.61' from calculated position.

B. Description of corner evidence found and/or method applied in restoring or reestablishing corner:

- 11 Corner position established at intersection of South and West one-sixteenth lines of Section 2. Found iron pipe was rejected since it is too far north and has no prior record.
- 12 Corner position established mid-point and on-line between the South and Center Quarter corners of Section 2.
- 15 Corner position established mid-point and on-line between the Southwest and South Quarter corners of Section 2. Found iron pipe was rejected as it is east of a mid-point position.

C. Description of monument for corner and accessories established to perpetuate locating the position of the corner:

11 - DNR Monument	12 - DNR Monument	15 - DNR Monument
7" R.Maple N19°E 23.0'	4" R.Maple N75°E 35.35'	8" Sugar N71°E 16.75'
6" R.Maple S68°E 23.15'	6" R.Maple S09°E 31.4'	6" Sugar S31°E 25.4'
4" R.Maple S68°W 16.9'	4" R.Maple S80°W 15.75'	7" Sugar S27°W 15.15'
8" R.Maple N65°W 25.7'	5" R.Maple N68°W 15.0'	9" Sugar N62°W 19.3'

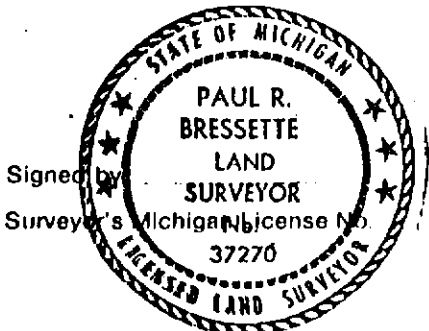

*Paul R. Bressette* Date June 1, 1994  
37270