

LAND CORNER RECORDATION CERTIFICATE
Filing Requirement of Act 74, Mich. P.A. 1970

For corners in


Table with columns: Menominee (County), Located In, Corner Code. Rows include Public Land Survey, Property Controlling in Section, and Miscellaneous Property in Sec.

Register of Deeds Stamp & File Number

- 4. Lot No. , Recorded Plat
5. Private Claims

I, Paul Bressette in a field survey on May 26 1994 do hereby certify that under requirements of P.A. 74, Michigan P.A. of 1970, the corner points mentioned in lines 1 and 2 above were in conformance with regulations and rules therefore as required in the current manual of survey instructions of the United States Department of the Interior, Bureau of Land Management or by a decree of a Court of Law and/or that the corner points mentioned in lines 3, 4 and 5 above were in conformance with the rules of the Michigan Board of Land Surveyors or by a Decree of a Court of Law; established, re-established, monumented, re-monumented, recovered, found as expressed below:

NOTE: Not more than 4 corners, all in the same town and range, may be recorded on this certificate.

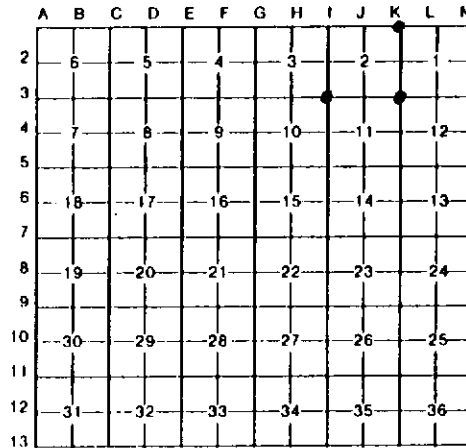

A. Description of original monument and accessories and/or subsequent restoration:

- I-3 Section Corner common to Sections 2, 3, 10 and 11. 1852: Francis Coleman, D.S., set wood post witnessed by: Black Ash 12 N55E 32 Lks.; Elm 10 S71W 46 Lks.
K-1 Section Corner common to Sections 1, 2, 35 and 36. 1957: Billy D. Buckler, RLS, set 1" iron pipe with brass cap witnessed by: 5" Cedar S20E 42 Lks; 7" Tamarack S55W 17 Lks; 7" Tamarack N79E 14.5 Lks.
K-3 Section Corner common to Sections 1, 2, 11 and 12. 1955: Michigan DNR. Set 1" iron pipe witnessed by: 12" Red Pine S65W 59 Lks.; 18" White Pine S69E 56 Lks.


B. Description of corner evidence found and/or method applied in restoring or reestablishing corner:

- I-3 No evidence of original survey or restoration found. Corner position re-established by double proportion between original corners one mile north and one mile east, a very well defined swamp edge to the south, and a position to the west calculated from recovered plat monuments of "Menominee Forest Estates No. 1".
K-1 Found monument and NBT's as described. Cedar is a blow-down with faces facing the ground. Measurements to tamaracks match well, but appear to have been recorded to wrong trees. Rewitnessed monument as found.
K-3 Found monument and NBT's as described. Monument was bent over and cap was broken off. White Pine NBT is dead but still standing. Set new monument and rewitnessed.

C. Description of monument for corner and accessories established to perpetuate locating the position of the corner:

Table with 3 columns: I-3 DNR Monument, K-1 DNR (Brass Cap), K-3 DNR Monument. Lists monument types and measurements such as 10" Maple N59E 12.0', \*13" Tamarack N85E 11.3', 17" R.Pine S42E 73.3'.

\*Old NBT's

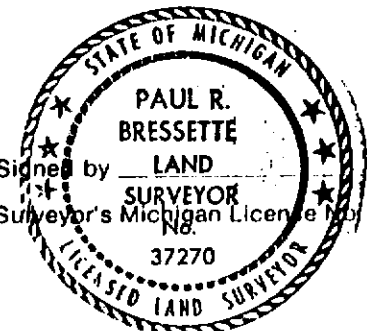

Paul R. Bressette Date

June 1, 1994

37270